IREDELL COUNTY HEALTH DEPARTMENT

STATESVILLE 704-878-5305 MOORESVILLE 704-664-5281

IMPROVEMENT PERMIT / AUTHORIZATION TO CONSTRUCT / OPERATION PERMIT / EXISTING SYSTEM INSPECTION

PERMIT# 143850 PIN# 4705 31 8048 DATE 16 July 07

OWNER OR APPLICANT Heritage Bld. PHONE: Business 704-528-6644 Home

ADDRESS 120 Hickory Pl. Ct. Statesville, No. C.

LOCATION Old Mtn. Rd. Turn into Alexander Knolls!

SUBDIVISION Alexander Knoll BLOCK / SECTION 2 LOT 58 (58) LOT AREA 0.697Ac. SITE CLASS. NS DESIGN FLOW 360gpd L.T.A.R. 0.3 gpd/ft²

Septic Tank: 1000 Gallons; STB STB1000-2WD Date 4-3-07

Pump Tank: Gallons; PT Date

Pump Make: Model Serial No.

Nitrification Field: No Fields 1 Square Feet 1200 Linear Feet 300

No Lines 4 Trench Width 36" Max Trench Bottom Depth 36" Gravel Depth ☐ Gravity ☐ Pressure

☑ New System ☐ Repair ☐ Expansion System Type: I II III IV V VI

System Description: 25% Red.

Repair System Description: 25% Red.

Maintenance Agreement Required: ☐ Yes ☑ No

☐ House/Mod. Home No. Bedrooms 3

☐ Mobile Home No. Persons

☐ Business No. Employees

☐ Other


Water Supply: ☐ Individual ☑ Public ☐ Community

☐ Slab ☑ Crawl Space ☐ Basement w/plumbing ☐ Basement wo/plumbing


Comments:/Conditions:

Comments:/Conditions: 5T this marker / Tough-Life Sidewalk

INITIAL SITE SKETCH

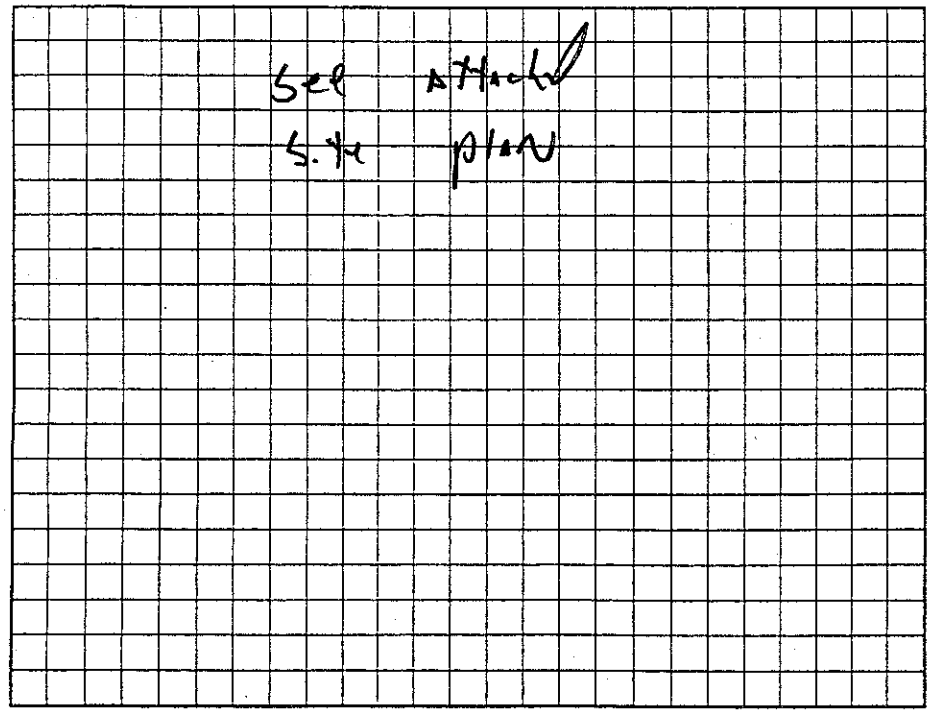

AS BUILT SKETCH

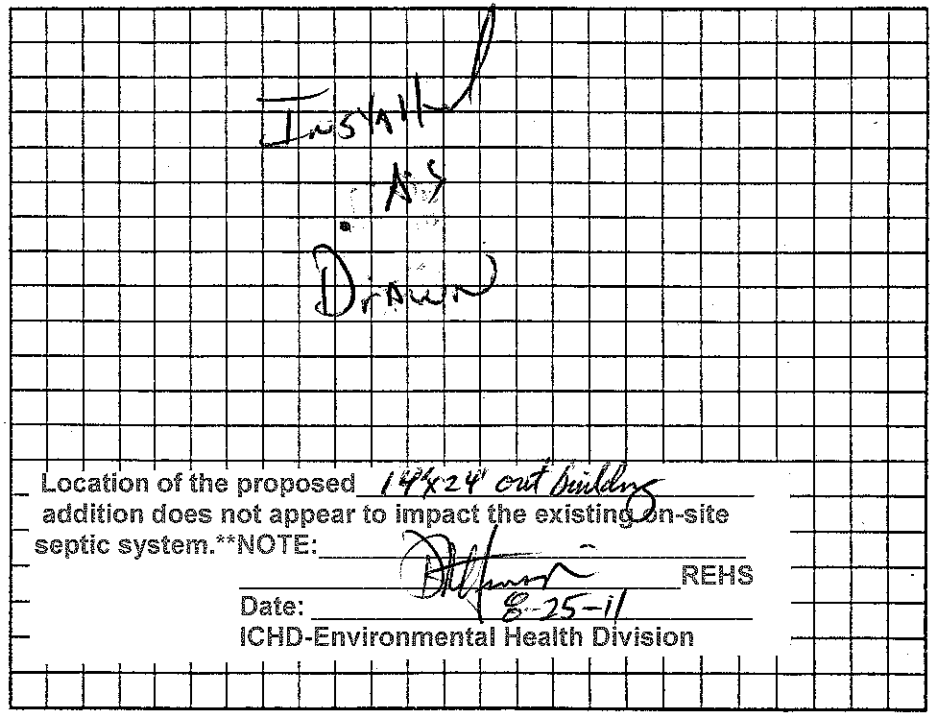

Location of the proposed 14'x24' out building addition does not appear to impact the existing on-site septic system.**NOTE:

REHS

Date: 8-25-11

ICHD-Environmental Health Division

Permit can be suspended or revoked if any false information is supplied toward securing the permit/any unauthorized changes are made to the site/any unauthorized changes are made in the installation of the system. Improvement Permit with plat valid without expiration ☐ Improvement Permit with site plan valid for sixty months ☑ Authorization to Construct is valid for a period equal to that of Improvement Permit – not to exceed sixty months.

Signed: date 7-16-07

Improvement Permit by: R.S. date 16 July 07

Authorization to Construct by: R.S. date 16 July 07

Installed by: Ryan Grady

Operation Permit by: R.S. date 8 Oct. 07

Existing System Inspection by: date

HEALTH DEPT. COPY: WHITE OWNER COPY (FINAL): YELLOW OWNER COPY (INITIAL): PINK

ALEXANDER KNOLL DR
PB 49-96
110
110
1000
118
89
58
146
249
260
274
59
58
274
066
57
56
217
207
111
283
110
112
112
086
61
1 inch equals 50 feet