IREDELL COUNTY HEALTH DEPARTMENT

STATESVILLE 704-878-5305 (cr) MOORESVILLE 704-664-5281

IMPROVEMENT PERMIT / AUTHORIZATION TO CONSTRUCT / OPERATION PERMIT / EXISTING SYSTEM INSPECTION

PERMIT# 12232 PIN# 4705-31-9502 DATE 7/13/04

OWNER OR CONTRACTOR Heritage Bldg Company PHONE: Business (704) 528-6644 Home

ADDRESS 120 Hickory Place Court Statesville NC 28677

LOCATION I-40 W, @ old NC 90 Rd @ Alpine Creek on left

SUBDIVISION Alexander Knoll BLOCK / SECTION — LOT 46 LOT AREA .646 Ac SITE CLASS. PS DESIGN FLOW 360 L.T.A.R. .35 gpd

Septic Tank: 1,000 Gallons; STB 1012 Date 6-13-04
Pump Tank: _____ Gallons; PT _____ Date _____
Pump Make: _____ Model _____ Serial No. _____
Nitrification Field: No Fields 1 Square Feet Eq to 1029 Linear Feet 260
No Lines 4 Trench Width 36" Max Trench Bottom Depth 36" Gravel Depth NA

☒ New System ☐ Repair System Type: I, II, III, IV, V, VI
System Description: Gravity 25% Reduction
Repair System Description: Pump 50% Reduction
Maintenance Agreement Required: ☐ Yes ☒ No

☒ House/Mod. Home ☐ Mobile Home ☐ Business ☐ Other
No. Bedrooms 3 No. Bathrooms ____ No. Employees ____


☐ Slab ☒ Crawl Space ☐ Basement w/plumbing ☐ Basement wo/plumbing

Water Supply: ☐ Individual ☒ Public ☐ Community

Comments:/Conditions: ① Install liner on contour ② Maintain proper setbacks

Comments:/Conditions: SEPTIC TANK WITH MARKER INSTALLED USING "TUFFITE" FILTER

INITIAL SITE SKETCH

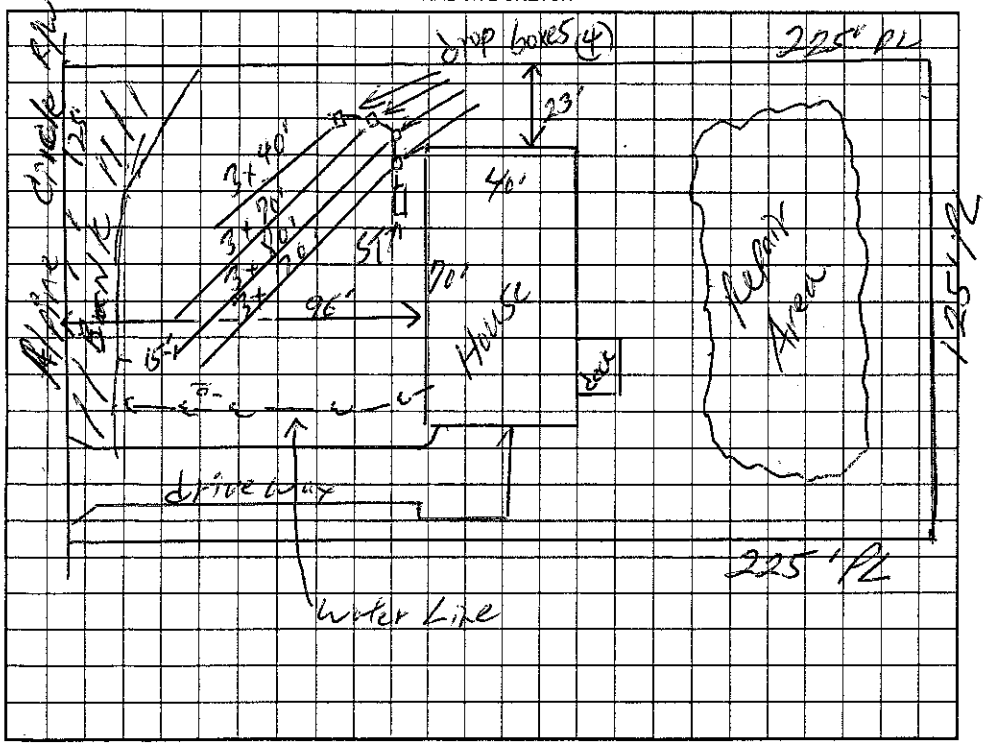

AS BUILT SKETCH

SYSTEM INSTALLED ACCORDING TO INITAL SITE SKETCH

Permit can be suspended or revoked if any false information is supplied toward securing the permit/any unauthorized changes are made to the site/any unauthorized changes are made in the installation of the system. Improvement Permit with plat valid without expiration. Improvement Permit with site plan valid for sixty months. Authorization to Construct is valid for a period equal to that of Improvement Permit – not to exceed sixty months.

Signed: _____ date 7-13-04 Installed by: TOMMY FRYE

Improvement Permit by: William O. Johnson date 7/13/04 Operation Permit by: STEVE HEDRICK date 10-21-04

Authorization to Construct by: William O. Johnson date 7/13/04 Existing System Inspection by: _____ date _____

HEALTH DEPT. COPY: WHITE OWNER COPY (FINAL): YELLOW OWNER COPY (INITIAL): PINK