REPAIR

# IREDELL COUNTY HEALTH DEPARTMENT

STATESVILLE 704-878-5305 MOORESVILLE 704-664-5281

## IMPROVEMENT PERMIT / AUTHORIZATION TO CONSTRUCT / OPERATION PERMIT / EXISTING SYSTEM INSPECTION

PERMIT# 8771 Repair PIN# 4705330573 DATE Feb 23, 2000

OWNER OR CONTRACTOR Chris Davidson PHONE: Business 363 2634 Home

ADDRESS

LOCATION Old MT Rd (R) Massey Dead (R) Horseshoe Lp (L) Robinette Lt 2nd on Left

SUBDIVISION BLOCK / SECTION LOT LOT AREA SITE CLASS DESIGN FLOW L.T.A.R.

Septic Tank: 1000 Gallons: STB 812 Date 11/09/99
Pump Tank: Gallons: PT Date
Pump Make: Model Serial No.
Nitrification Field: No Fields 2 Square Feet Existing Linear Feet Existing
No Lines Trench Width Max Trench Bottom Depth Gravel Depth 16"

☐ New System ☒ Repair System Type: I, II, III, IV, V, VI
System Description: Conv Gravity
Repair System Description: Pump
Maintenance Agreement Required: ☐ Yes ☒ No

☒ House/Mod. Home No. Bedrooms 3
☐ Mobile Home No. Bathrooms 2
☐ Business No. Employees
☐ Other


☐ Slab ☒ Crawl Space ☐ Basement w/plumbing ☐ Basement wo/plumbing

Water Supply: ☐ Individual ☒ Public ☐ Community


Comments/Conditions: CARE should be TAKEN NOT TO drive over Septic Lines
Position New TANK To insure fall To Distribution Box

Comments/Conditions:

INITIAL SITE SKETCH

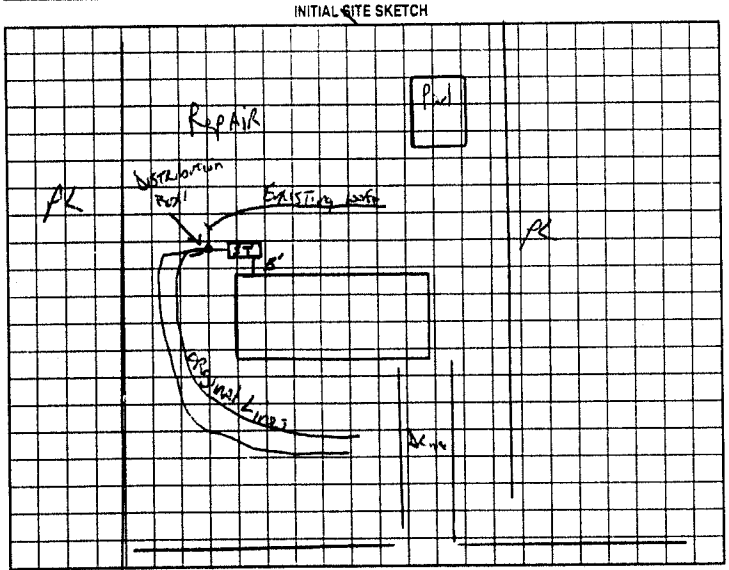


AS BUILT SKETCH

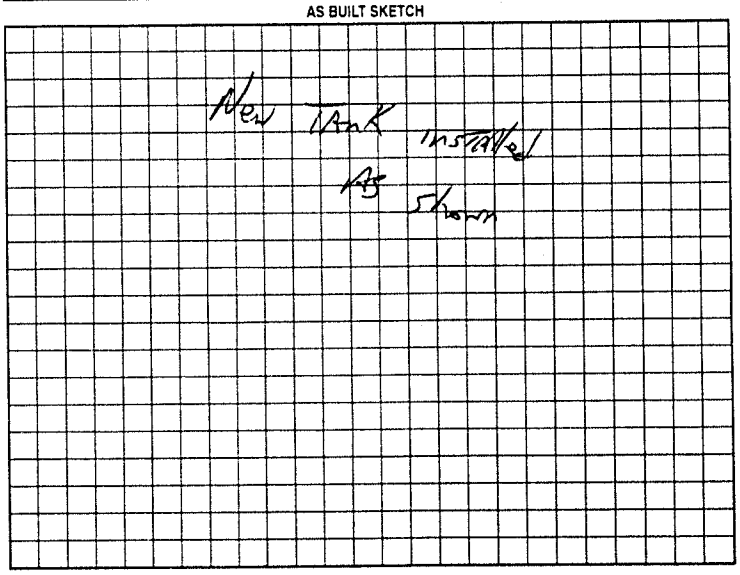


Permit can be suspended or revoked if any false information is supplied toward securing the permit/any unauthorized changes are made to the site/any unauthorized changes are made in the installation of the system. Improvement Permit with plat valid without expiration. Improvement Permit with site plan valid for sixty months. Authorization to Construct is valid for a period equal to that of Improvement Permit – not to exceed sixty months.

Signed: Neal Hall date 1-24-00 Installed by: C Davidson

Improvement Permit by: C Potter date Feb 23 2000 Operation Permit by: C Potter date Feb 25 2000

Authorization to Construct by: C Potter date Feb 23 2000 Existing System Inspection by: date

HEALTH DEPT. COPY: WHITE OWNER COPY (FINAL): YELLOW OWNER COPY (INITIAL): PINK