IREDELL COUNTY HEALTH DEPARTMENT

STATESVILLE 704-878-5305 MOORESVILLE 704-664-5281

IMPROVEMENT PERMIT / AUTHORIZATION TO CONSTRUCT / OPERATION PERMIT / EXISTING SYSTEM INSPECTION

PERMIT # 157178 PIN # [redacted] 4705331278 DATE 7-16-09

OWNER or APPLICANT Robert Hardwick PHONE: Business 708-710-6703 Home:

OWNER or APPLICANT ADDRESS 123 Robinette Lane Statesville NC 28677

LOCATION / DIRECTIONS 40 WEST (R) OMR (R) MASSEY DEAL (L) Horseshoe Loop (L) Robinette 2ND HOUSE ON LEFT

SUBDIVISION On PERRY BLOCK / SECTION LOT # 73-76 LOT AREA .435 DESIGN FLOW L.T.A.R.

Septic Tank Existing Gallons: STB Date
Pump Tank Gallons: PT Date
Pump Make Model Serial #
Nitrification Field No Fields 1 No Lines 2 Linear Feet ≈250'
Trench Width Max. Trench Bottom Depth Gravel Depth

☐ New System ☐ Repair ☐ Expansion System Type I (II) III IV V VI
System Description:
Repair System Description:
Maintenance Agreement Required ☐ YES ☒ NO
☒ GRAVITY ☐ PRESSURE

☐ Residence No. Bedrooms
☐ Business No. Persons
☒ Other No. Employees
☐ Slab ☐ Crawl Space
☐ Basement w/plumbing ☐ Basement w/o plumbing

Water Supply
☐ Private
☒ Public
☐ Community

Comments / Conditions (1) This is an existing system check for a 24'x30' Building with no plumbing (2) System probed by supervisor and environmental health spec it was properly functioning at time of check.

INITIAL SITE SKETCH

SEE ATTACHED EXISTING SYSTEM CHECK

Comments / Conditions (3) Visit was made by supervisor with env. health spec. to the site before approval was given. (4) OLD RELOCO FOUND WAS DETERMINED TO BE INCORRECT BECAUSE DIMENSIONS DID NOT MATCH UP.

AS BUILT SKETCH

(5) RELOCO OF SYSTEM ON THIS LOT WAS NEVER LOCATED.

Permit can be suspended or revoked if any false information is supplied toward securing the permit / any unauthorized changes are made to the site / any unauthorized changes are made in the installation of the system.

☐ *IMPROVEMENT PERMIT w / plat valid without expiration.* ☐ *IMPROVEMENT PERMIT w / site plan valid for 60 mos.* ☒ *AUTHORIZATION TO CONSTRUCT valid for period equal to IMPROVEMENT PERMIT-not to exceed 60 mo.*

Owner / Applicant Signature: Robert Hardwick Date 7-16-09

Improvement Permit by: Date

Authorization to Construct by: Date

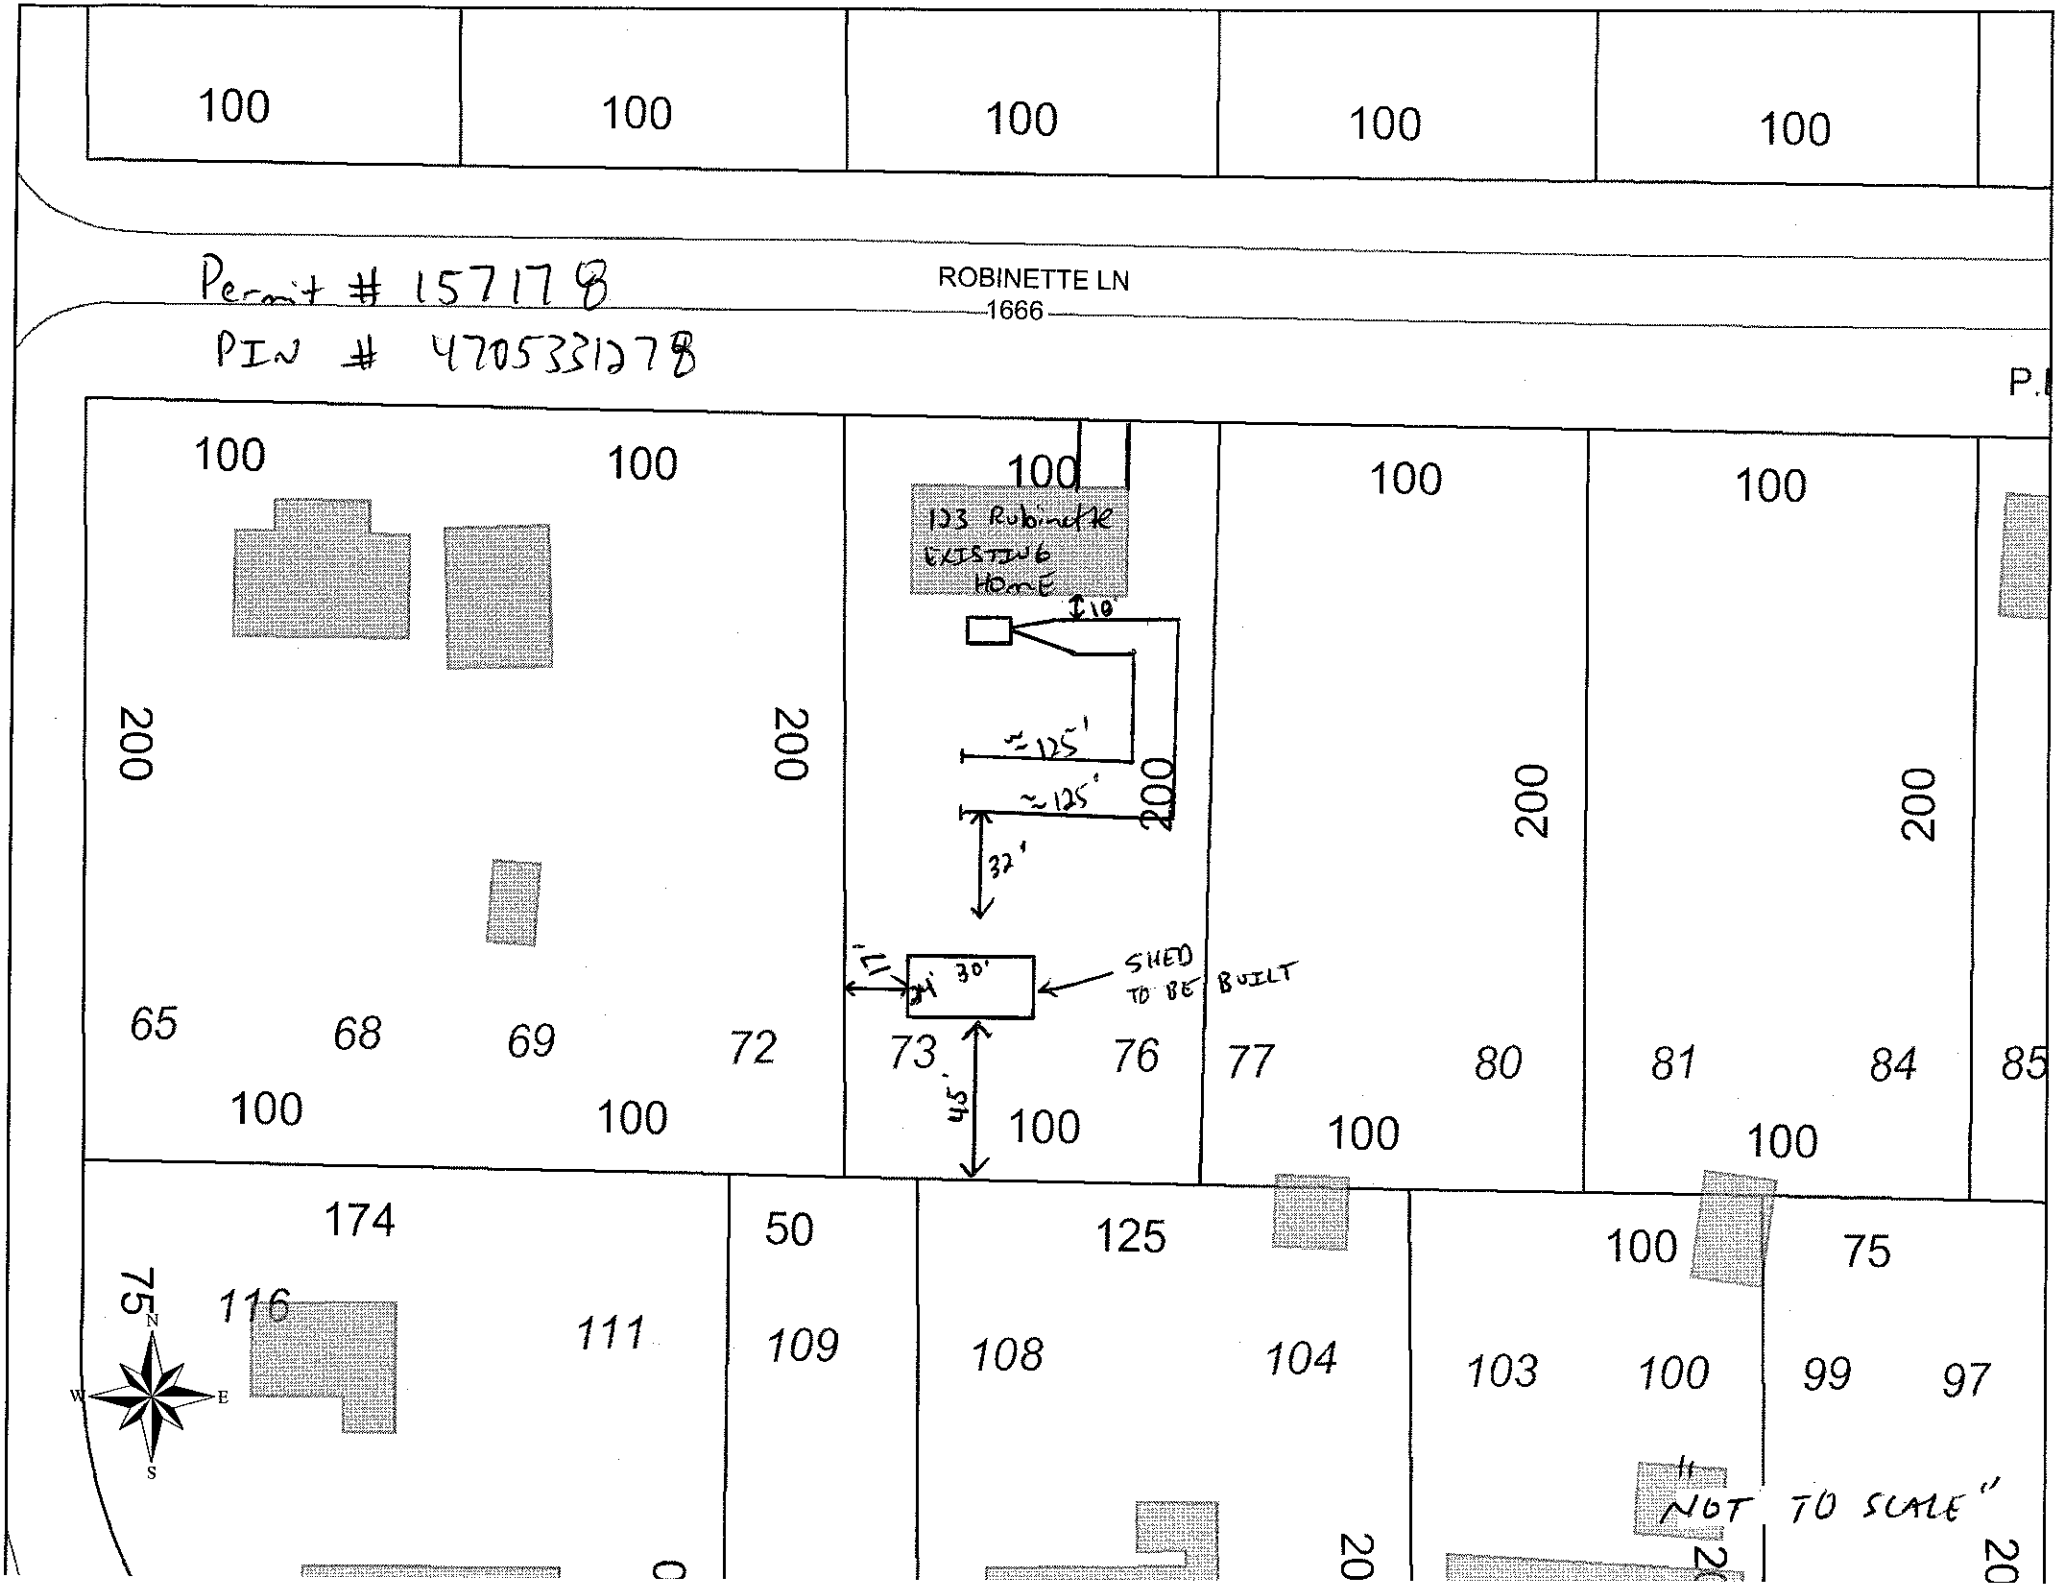
YOU SHOULD CONTACT A LOCATOR SERVICE PRIOR TO ANY EXCAVATION.

Installed by:

Operation Permit by: Date:

Existing System Inspected by: [signature] Date: 7/16-09

WHITE COPY Environmental Health YELLOW COPY (Final) Owner / Applicant PINK COPY (Initial) Owner / Applicant


100
100
100
100
100
Permit # 157178
PIN # 4705331278
ROBINETTE LN
1666
100
100
100
123 Robinette
EXISTING
HOME
100
100
100
10'
~125'
~125'
200
200
200
200
200
37'
17'
30'
SHED TO BE BUILT
65
68
69
72
73
76
77
80
81
84
85
45'
100
100
100
100
100
174
116
111
50
109
125
108
104
100
75
103
100
99
97
75
N
W
E
S
"NOT TO SCALE"