IREDELL COUNTY HEALTH DEPARTMENT

STATESVILLE 704-878-5305 MOORESVILLE 704-664-5281

IMPROVEMENT PERMIT / AUTHORIZATION TO CONSTRUCT / OPERATION PERMIT / EXISTING SYSTEM INSPECTION

PERMIT # Repair PIN # 4705-33-1764 DATE 4-23-10

OWNER or APPLICANT Johnny B. Conner PHONE: Business 704 872 9804 Home:

OWNER or APPLICANT ADDRESS 1330 Massey Dead

LOCATION / DIRECTIONS 64W to (L) on Liggard Farm, (R) on Massey Dead, 5th house on left.

SUBDIVISION n/a BLOCK / SECTION LOT # LOT AREA DESIGN FLOW 360 L.T.A.R. 3

Septic Tank Ex. 1000 Gallons: STB Ex. 1012 Date Ex 9-10-09

Pump Tank Gallons: P T Date

Pump Make Model Serial #

Nitrification Field No Fields 1 No Lines 4 Linear Feet 400

Trench Width 36" Max. Trench Bottom Depth 36" Gravel Depth 12" ☒ GRAVITY ☐ PRESSURE

☐ New System ☒ Repair ☐ Expansion System Type I II III IV V VI

System Description:

Repair System Description: Conventional Gravity or Equivalent

Maintenance Agreement Required ☐ YES ☒ NO

☒ Residence No. Bedrooms 3 ☐ Business No. Persons ☐ Other No. Employees ☐ Slab ☒ Crawl Space ☐ Basement w/plumbing ☐ Basement w/o plumbing


Water Supply: ☐ Private ☒ Public ☐ Community

Comments / Conditions

400' of gravel or 300' of 25% Reduction

Comments / Conditions

INITIAL SITE SKETCH

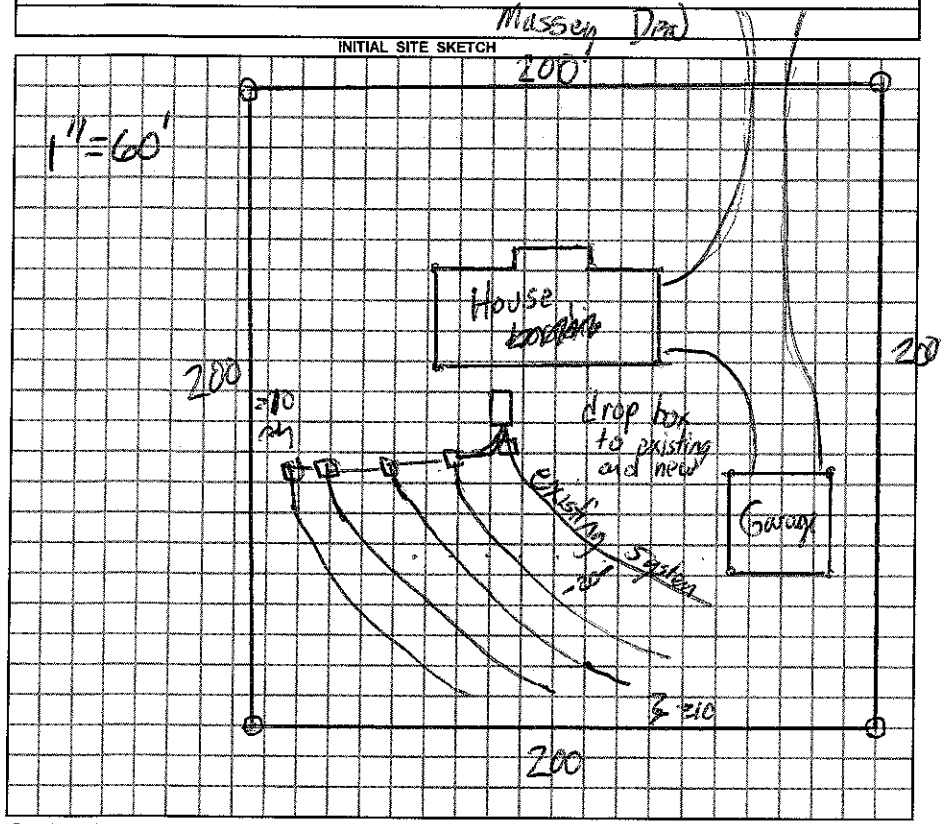

AS BUILT SKETCH

Permit can be suspended or revoked if any false information is supplied toward securing the permit / any unauthorized changes are made to the site / any unauthorized changes are made in the installation of the system.

☐ *IMPROVEMENT PERMIT w / plat valid without expiration.* ☒ *IMPROVEMENT PERMIT w / site plan valid for 60 mos.* ☒ *AUTHORIZATION TO CONSTRUCT valid for period equal to IMPROVEMENT PERMIT-not to exceed 60 mo.*

Owner / Applicant Signature: Johnny Burdette Conner Date 5-4-10

Improvement Permit by: Date 4-23-10

Authorzation to Construct by: Date 4-23-10

Installed by: Wes Lytton

Operation Permit by: Date: 5-26-10

Existing System Inspected by: Date:

YOU SHOULD CONTACT A LOCATOR SERVICE PRIOR TO ANY EXCAVATION.

WHITE COPY Environmental Health YELLOW COPY (Final) Owner / Applicant PINK COPY (Initial) Owner / Applicant