IREDELL COUNTY HEALTH DEPARTMENT

IMPROVEMENT PERMIT AND CERTIFICATE OF COMPLETION / OPERATIONS PERMIT

OWNER OR CONTRACTOR SHARON STIKELEATHER DATE 2-5-92. PERMIT NO. _____

PHONE: Business _____ Home _____

LOCATION Massey Dean Rd. off Liggard Farm Rd. - go approx. 1/4 mi. T.L. on Horseshoe Loop - T.R. on Robinette Rd. 2nd house on R. S.R. No. _____

SUBDIVISION NAME _____ LOT NO. _____ SECTION OR BLOCK NO. _____

House ☑ Mobile Home ☐ Business ☐ Other Repair.

No. Bedrooms _____ No. Bathrooms _____

Garbage Disposal Unit Yes ☐ No ☐

Auto. Dishwasher Yes ☐ No ☐

Auto. Wash. Machine Yes ☑ No ☐

Lot Area Ample.

Soil Characteristics _____


Application Rate _____

Topography _____

Depth to Water Table Repair.

Rock or other impervious formations _____

_____ Basement with Plumbing _____ Basement without Plumbing ✓ No Basement _____ Crawl Space

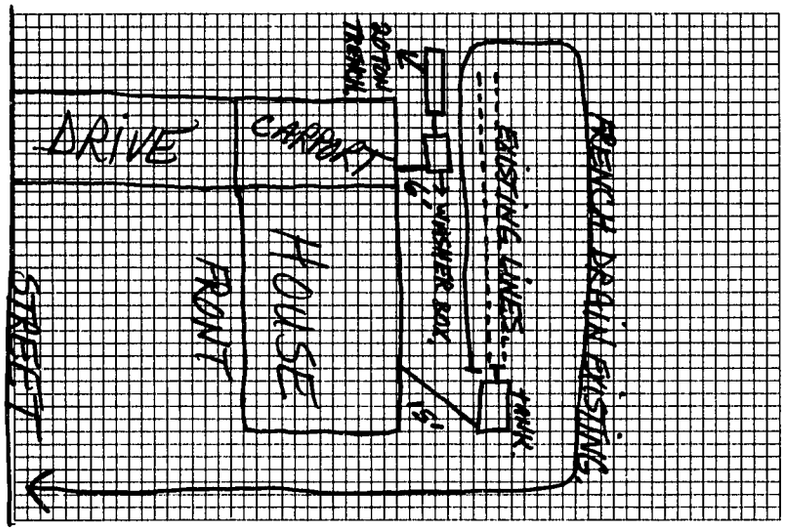

Plan of System (Not to Scale)

Size of Tank EXISTING. Gals.

Nitrification Field:

No. of Lines _____

Sq. Ft. _____ Linear Ft. _____

Depth of Stone in Lines _____

Water Supply: Individual ☐ Public ☑

20 TON TRENCH + 75 GAL. WASHER BOX INSTALLED.

Installed by Wes Lytton

I understand and agree to install a septic tank system as specified on this Improvement Permit.

Signed: _____

(IMPROVEMENT PERMIT IS VALID FOR 60 MONTHS FROM DATE OF ISSUE.)

IMPROVEMENT PERMIT BY Steve Braun

COMMENTS This repair system serves the washing machine wastewater only.

CERTIFICATE OF COMPLETION BY Steve Braun DATE 2-5-92.

EXISTING SYSTEM CHECKED BY _____ DATE _____

CONSTRUCTION MUST COMPLY WITH ALL OTHER APPLICABLE STATE AND LOCAL REGULATIONS

Permit is VOID if any unauthorized changes are made in installation of system, and/or if any unapproved changes are made to the site, and/or if any false information is supplied toward securing Improvement Permit.

Health Dept. Copy: White Inspection Dept. Copy: Yellow Sanitarian's Copy: Pink Owner's Copy: Gold