IREDELL COUNTY HEALTH DEPARTMENT - *ENVIRONMENTAL HEALTH* ☐ STATESVILLE OFFICE 704-878-5305 ☐ MOORESVILLE OFFICE 704-664-5281

IMPROVEMENT PERMIT / AUTHORIZATION TO CONSTRUCT / OPERATION PERMIT / EXISTING SYSTEM INSPECTION

PERMIT # 168374 PIN # 4705-33-5563 DATE 3 October 2011

OWNER William Stamey APPLICANT: PHONE: Home/Cell # (704) 902-3998 Business #

SITE ADDRESS 102 Robinette Ln OWNER / APPLICANT ADDRESS

SITE DIRECTIONS Massey Dead Rd. Turn onto Horseshoe Loop. Corner of Robinette & Horseshoe Loop.

SUBDIVISION BLOCK / SECTION LOT # LOT AREA 20,000 Ft² DESIGN FLOW 360 gpd L.T.A.R. Exist.

Exist Septic Tank 1400 Gallons: STB Date

Pump Tank Gallons: P T Date

Pump Make Model Serial #

Exist No. Nitrification Fields: 1 No. Lines Exist Linear Feet 250 Exist

Trench Width NA Max. Trench Bottom Depth ~2 Gravel Depth NA

☐ New System ☐ Repair ☐ Expansion System Type I II III IV V VI

System Description: Exist. Gravel bed.

Repair System Description:

Maintenance Agreement Required ☐ YES ☑ NO

☑ GRAVITY ☐ PRESSURE

☑ Residence No. Bedrooms 3

☐ Business No. Persons

☑ Other * No. Employees

☐ Slab ☑ Crawl Space

☐ Basement w/plumbing ☐ Basement w/o plumbing


Water Supply: ☐ Private ☑ Public ☐ Community

Comments / Conditions

* Addition 16'x18' utility room to house.

INITIAL SITE SKETCH

AS BUILT SKETCH

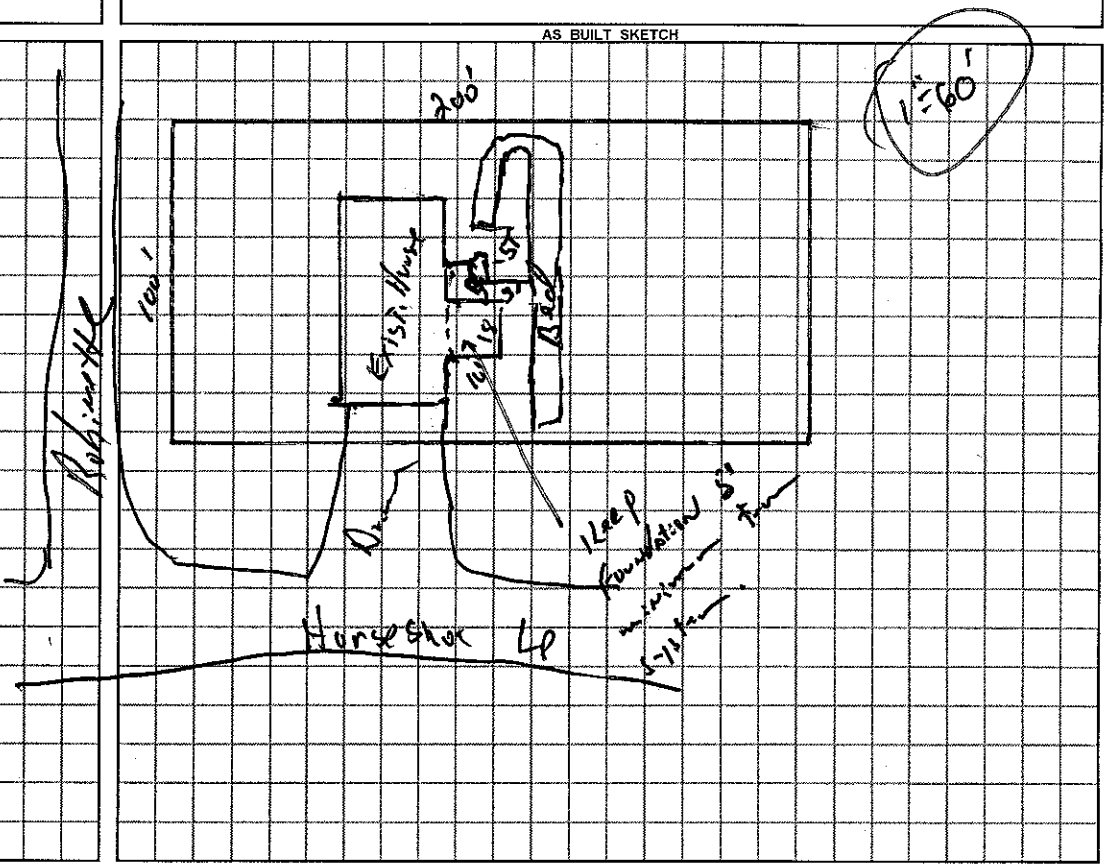

Permit can be suspended or revoked if any false information is supplied toward securing the permit / any unauthorized changes are made to the site / any unauthorized changes are made in the installation of the system.

☐ ***IMPROVEMENT PERMIT*** with plat valid without expiration. ☐ ***IMPROVEMENT PERMIT*** with plat valid without expiration. site plan valid 60 mo. ☐ ***AUTHORIZATION TO CONSTRUCT*** valid for period equal to IMPROVEMENT PERMIT--not to exceed 60 mo.

Owner / Applicant Signature: Wm T. Stamey Date 10-3-11 Installed by:

IMPROVEMENT PERMIT by: REHS Date

AUTHORIZATION TO CONSTRUCT by: REHS Date

OPERATION PERMIT by: REHS Date

Existing System Inspected by: REHS Date 30 Nov. 11

YOU SHOULD CONTACT A LOCATOR SERVICE PRIOR TO ANY EXCAVATION

White Copy – Environmental Health YELLOW COPY (Final) Owner / Applicant PINK COPY (Initial) Owner / Applicant