HUNTING CREEK BUILDING COMPANY

IREDELL COUNTY HEALTH DEPARTMENT

STATESVILLE 704-878-5305 MOORESVILLE 704-664-5281

IMPROVEMENT PERMIT / AUTHORIZATION TO CONSTRUCT / OPERATION PERMIT / EXISTING SYSTEM INSPECTION

PERMIT# 073571 PIN# 4705 34 5235 DATE 8-4-98

OWNER OR CONTRACTOR KENNETH GRAY PHONE: Business 539-5539 Home

ADDRESS 2767 OLD MOUNTAIN ROAD, STATESVILLE, NC 28625

LOCATION I-40 W, TR OLD MTN. RD, TR MASSEY DEAL, TL SPEARPOINT LANE, 2ND LOT ON LEFT

SUBDIVISION FLINT RIDGE BLOCK / SECTION III LOT 13 LOT AREA 0.841 ACRE SITE CLASS. PS DESIGN FLOW 360 L.T.A.R. 0.30 GPD/FT

Septic Tank: 1000 Gallons; STB 1000 Date 7-1-98
Pump Tank: ____ Gallons; PT ____ Date ____
Pump Make: ____ Model ____ Serial No. ____
Nitrification Field: No Fields 1 Square Feet EQ. TO 1200 Linear Feet 300FT
No Lines FIVE Trench Width 36" Max Trench Bottom Depth 36" Gravel Depth SAND 6"

☑ New System ☐ Repair System Type: I, II, III, IV, V, VI
System Description: 25% REDUCTION GRAVITY
Repair System Description: 25% REDUCTION GRAVITY
Maintenance Agreement Required: ☐ Yes ☑ No


☑ House/Mod. Home No. Bedrooms 3
☐ Mobile Home No. Bathrooms 2
☐ Business No. Employees ____
☐ Other ____
☐ Slab ☑ Crawl Space ☐ Basement w/plumbing ☐ Basement wo/plumbing

Water Supply: ☐ Individual ☑ Public ☐ Community

Comments:/Conditions: INSTALL 25% REDUCTION SYSTEM USING FIFTY CHAMBERS OR THERM H.D.S. SECTIONS AS FLAGGED USING DROP BOXES FOR SERIAL DISTRIBUTION.

Comments:/Conditions:

INITIAL SITE SKETCH

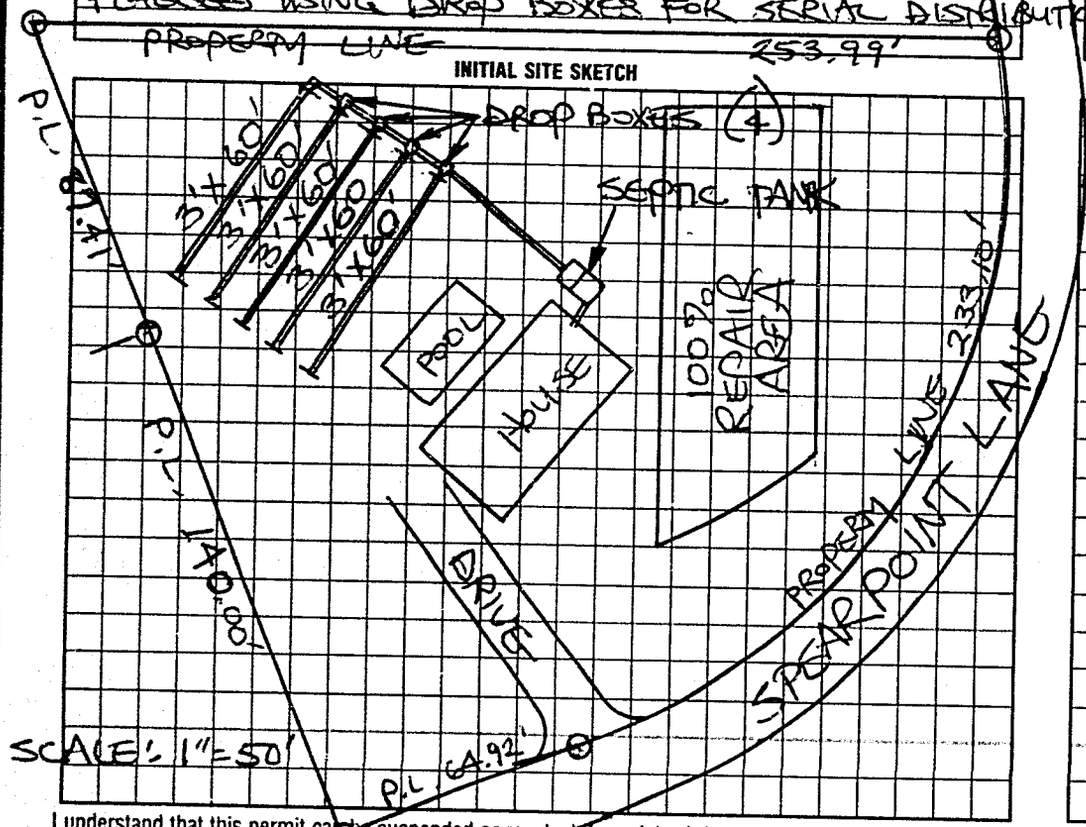

AS BUILT SKETCH

Same as initial sketch

I understand that this permit can be suspended or revoked if any false information is supplied toward securing the permit/any unauthorized changes are made to the site/any unauthorized changes are made in the installation of the system. Improvement Permit with plat valid without expiration. Improvement Permit with site plan valid for sixty months. Authorization to Construct is valid for a period equal to that of Improvement Permit – not to exceed sixty months.

Signed: Sandy Campbell Pres. date 8-17-98
Improvement Permit by: STEVE HEDRICK date 8-4-98
Authorization to Construct by: STEVE HEDRICK date 8-4-98

Installed by: Kenny Matison
Operation Permit by: B C Moore date 9-18-98
Existing System Inspection by: ____ date ____

HEALTH DEPT. COPY WHITE INSPECTION COPY (FINAL) GREEN OWNER COPY (FINAL) YELLOW INSPECTION COPY (INITIAL) PINK OWNER COPY (INITIAL) GOLD