IREDELL COUNTY HEALTH DEPARTMENT

STATESVILLE 704-878-5305 MOORESVILLE 704-664-5281

IMPROVEMENT PERMIT / AUTHORIZATION TO CONSTRUCT / OPERATION PERMIT / EXISTING SYSTEM INSPECTION

PERMIT# 124411 PIN# 4705-34-7268 DATE 11-5-04

OWNER OR CONTRACTOR DISTINCTIVE HOUSING INCORPORATED PHONE: Business (704) 528-7226 Home 704-878-9400

ADDRESS 164 BULLFINCH RD. MOORESVILLE NC 28117

LOCATION I-40W TR OMR TR MASSEY DEAL TL SPEARPOINT ON RT

SUBDIVISION FLINT RIDGE BLOCK / SECTION III LOT 20 LOT AREA .98 SITE CLASS. PS DESIGN FLOW 360 L.T.A.R. 0.3 gpd/ft²

Septic Tank: 1000 Gallons; STB 725 Date 11-4-04
Pump Tank: 1000 Gallons; PT 302 Date 11-16-04
Pump Make: ZOELLER Model N-137 Serial No. 137-0008
Nitrification Field: No Fields 1 Square Feet 1200 Linear Feet 300
No Lines 4 Trench Width 36" Max Trench Bottom Depth 36" Gravel Depth N/A

☑ New System ☐ Repair System Type: I, II, (III), IV, V, VI
System Description: PUMP 25% REDUCTION
Repair System Description: LP PANEL 50% RED
Maintenance Agreement Required: ☐ Yes ☑ No

☑ House/Mod. Home No. Bedrooms 3
☐ Mobile Home No. Bathrooms
☐ Business No. Employees
☐ Other


☐ Slab ☑ Crawl Space ☐ Basement w/plumbing ☐ Basement wo/plumbing

Water Supply: ☐ Individual ☑ Public ☐ Community

Comments:/Conditions: ① INSTALL LINES ON CONTOUR ② MAINTAIN SETBACKS ③ MUST GO IN ACCORDING TO SKETCH ④ SMOOTH OUT ROUGH TOPOGRAPHY OVER DRAINFIELD AREA.

Comments:/Conditions: ① BLUE POLYLOK FILTER ② SYSTEM USING "INFILTRATOR" CHAMBERS ③ TANKS MOVED TO RT SIDE OF HOUSE

INITIAL SITE SKETCH 1" = 50'

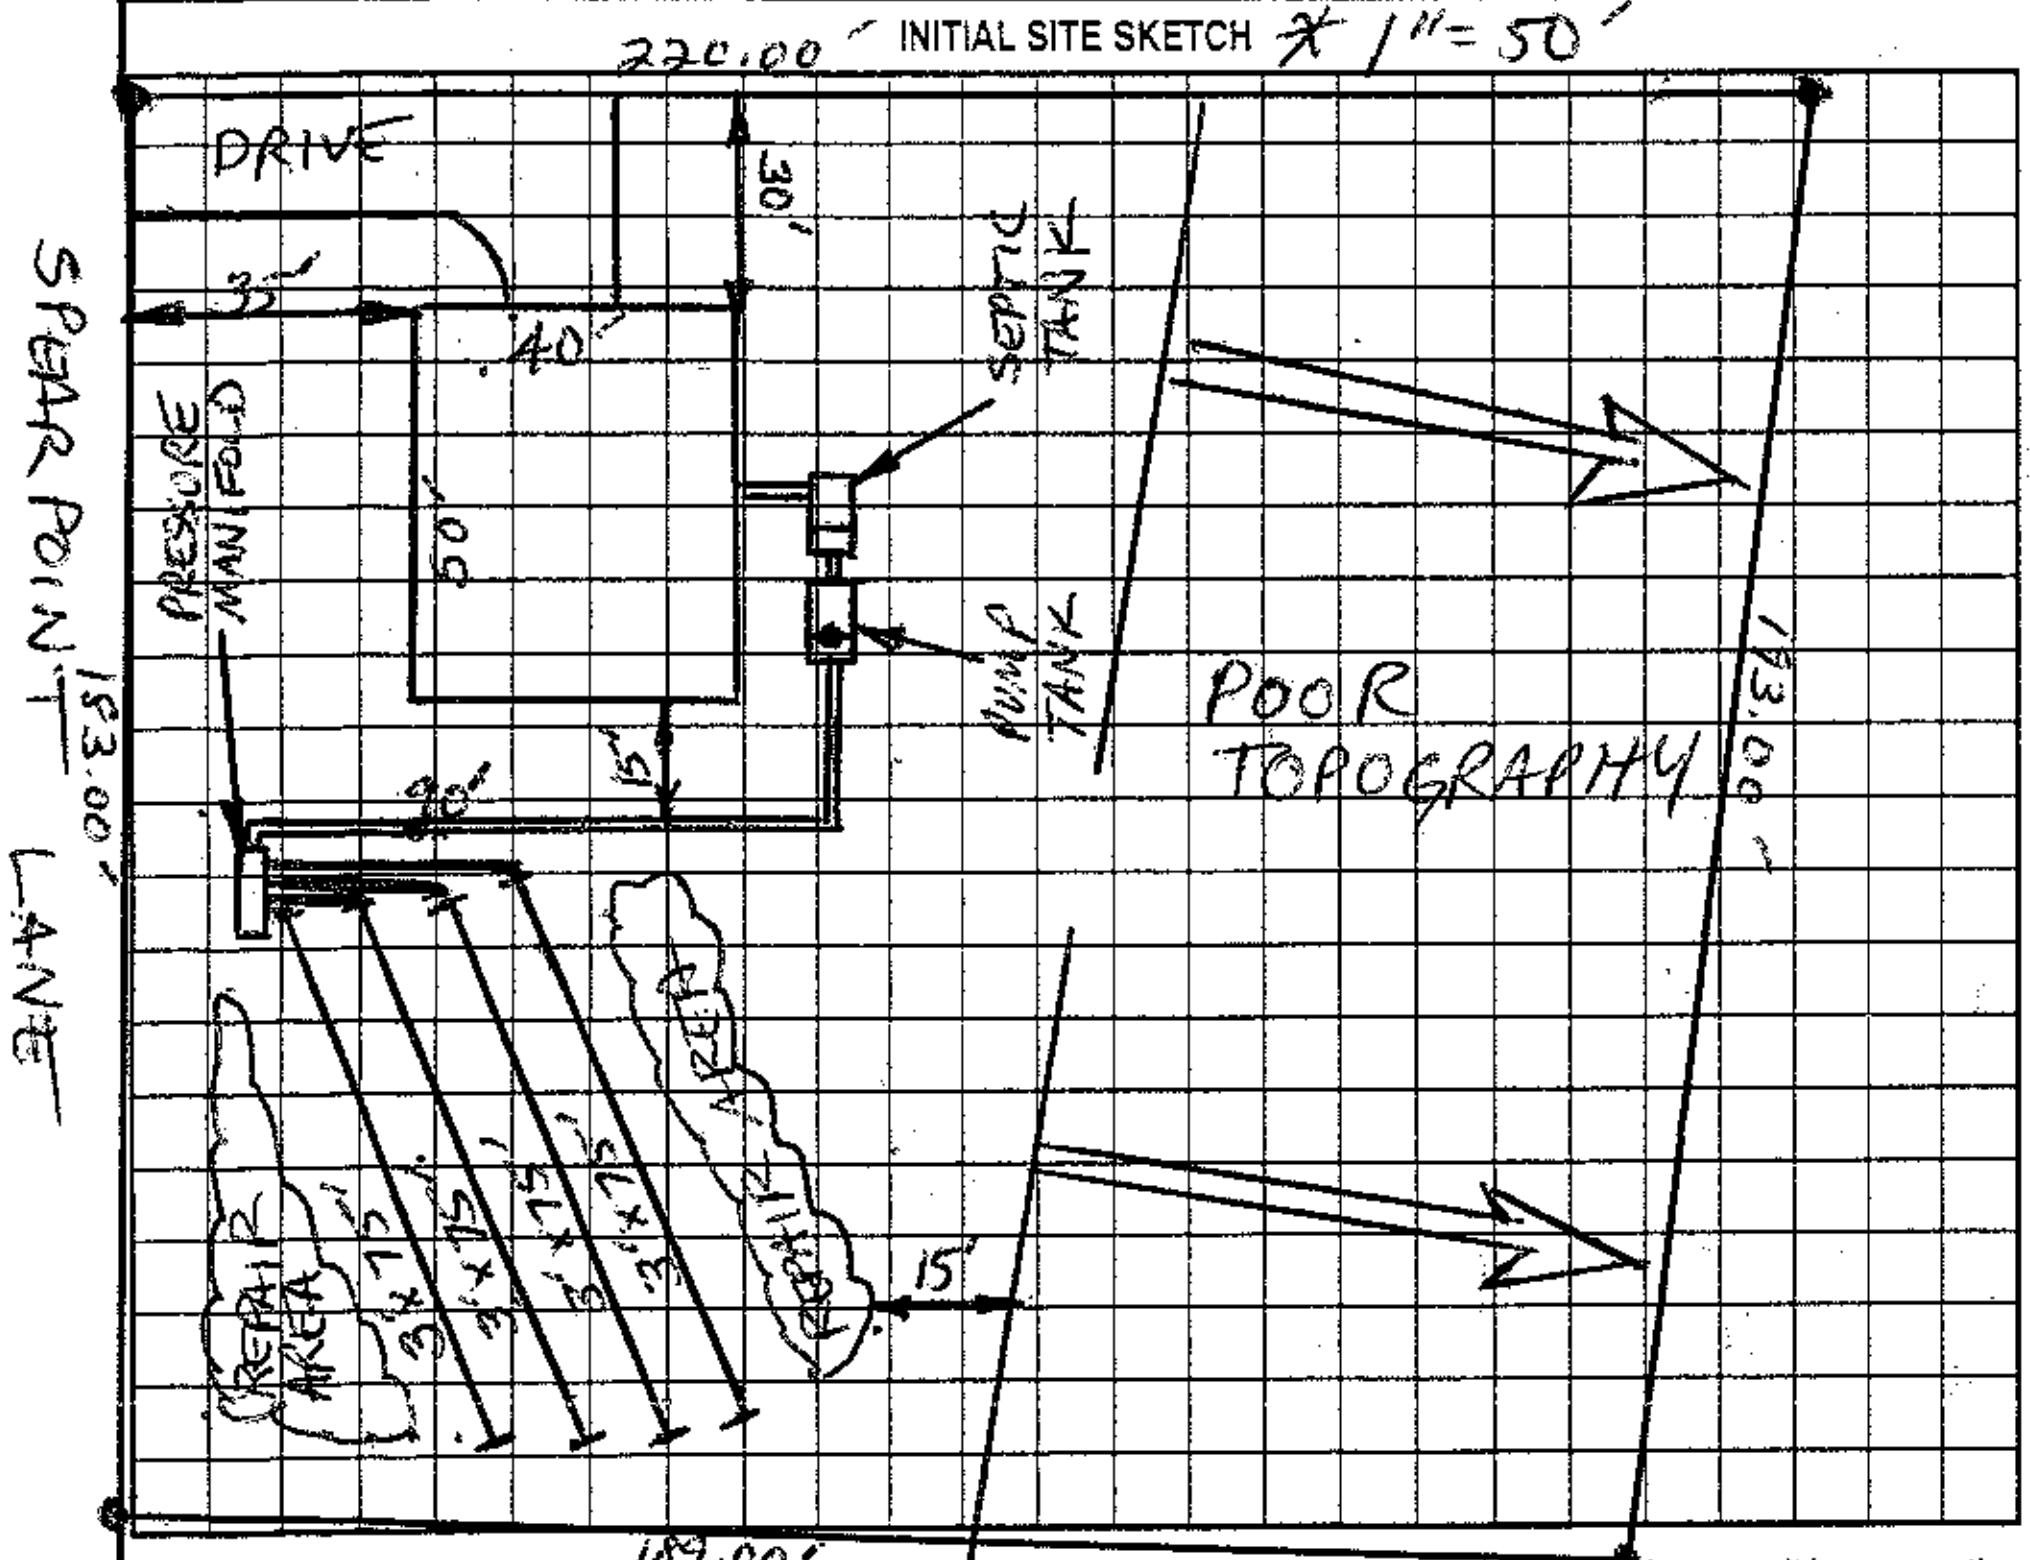

AS BUILT SKETCH

☑ SYSTEM INSTALLED ACCORDING TO SKETCH
☑ NEMA 4X WIRING, SEAL LC
☑ RISERS, FLOATS, 6"
☑ PUMP/ALARM WIRING LC
☑ PM, 2' PIPE 1-25-05
☑ PUMP TO PM BOX 1-25-05 CS

TURNDOWN ON 2-11-05 - NEEDS ALARM LABELED, NEMA 4X BOX SEALED, + 6" RISER ABOVE FINISH GRADE

2-14-05 LC ABOVE FG FIXED. EVERYTHING OK

Permit can be suspended or revoked if any false information is supplied toward securing the permit/any unauthorized changes are made to the site/any unauthorized changes are made in the installation of the system. Improvement Permit with plat valid without expiration, Improvement Permit with site plan valid for sixty months. Authorization to Construct is valid for a period equal to that of Improvement Permit – not to exceed sixty months.

Signed: [signature] date 11-12-2004 Installed by: ROWAN SEPTIC

Improvement Permit by: [signature] RS date 11-5-04 Operation Permit by: [signature] RS date 2-14-05

Authorization to Construct by: [signature] RS date 11-5-04 Existing System Inspection by: date

HEALTH DEPT. COPY: WHITE OWNER COPY (FINAL): YELLOW OWNER COPY (INITIAL): PINK