IREDELL COUNTY HEALTH DEPARTMENT

STATESVILLE 704-878-5305 MOORESVILLE 704-664-5281

IMPROVEMENT PERMIT / CERTIFICATE OF COMPLETION / OPERATION PERMIT / EXISTING SYSTEM INSPECTION

PROPERTY DESCRIPTION NO. 066545 DATE 6-7-97 TAX MAP NO. 4705476919 (PART) Watershed: ☐ Yes ☒ No

OWNER OR CONTRACTOR ERNEST RUNGE PHONE: Business Home 872-6645

ADDRESS 379 LONG ISLAND ROAD, STATESVILLE NC 28677

LOCATION US64 W, TL LIPPARD FARM, TR HAPPY ACRES, TL TRAILWAY, BEAR TO, 13TH LOT ON LEFT

SUBDIVISION CASA GRANDE BLOCK / SECTION II LOT 12 LOT AREA 1.72 ACRES SITE CLASS. PS DESIGN FLOW 360 L.T.A.R. 0.30 GPD/FT²

Septic Tank: 1000 Gallons; STB ____ Date ____

Pump Tank: ____ Gallons; PT ____ Date ____

Pump Make: ____ Model ____ Serial No. ____

Nitrification Field: No Fields 1 Square Feet 1200 Linear Feet 400

No Lines FOUR Trench Width 36" Max Trench Bottom Depth 36" Gravel Depth 12"

☒ New System ☐ Repair System Type: I, II, III, IV, V, VI

System Description: CONVENTIONAL GRAVITY

Repair System Description: PBPS pump/GRAV

Maintenance Agreement Required: ☐ Yes ☒ No

☐ House/Mod. Home ☒ Mobile Home ☐ Business ☐ Other

No. Bedrooms 3 No. Bathrooms 2 No. Employees ____


☐ Slab ☒ Crawl Space ☐ Basement w/plumbing ☐ Basement wo/plumbing

Water Supply: ☐ Individual ☐ Community ☒ Public


Comments:

Comments:

INITIAL SITE SKETCH SCALE: 1" = 60'

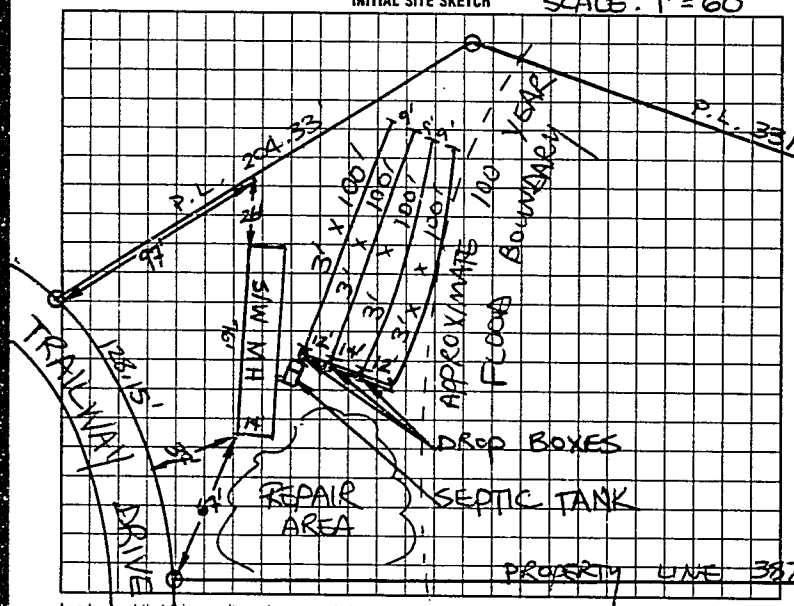

AS BUILT SKETCH

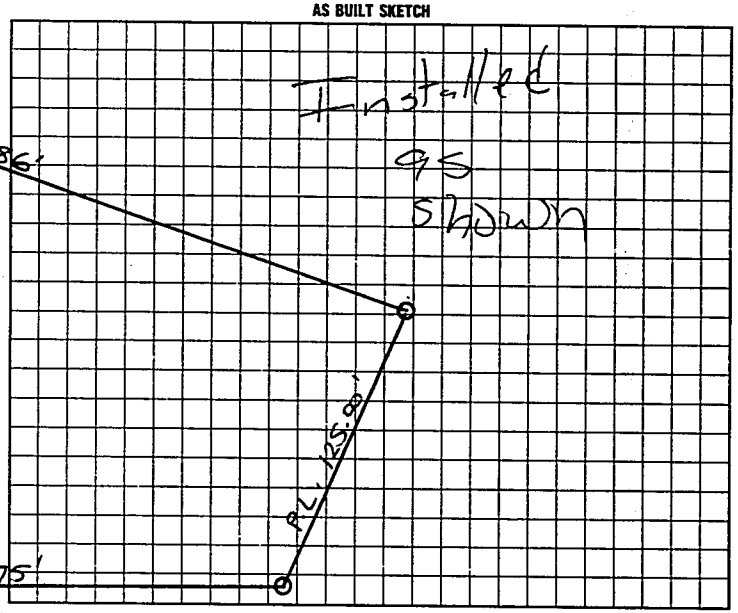

I understand that this permit can be suspended or revoked if any false information is supplied toward securing the permit/any unauthorized changes are made to the site/any unauthorized changes are made in the installation of the system. Improvement Permit is valid for 60 months from date of issuance. AUTHORIZATION TO CONSTRUCT IS VALID FOR 60 MONTHS FROM DATE OF ISSUANCE.

Signed: [signature]

Improvement Permit by: STEVE HEDRICK date 6-7-97

AUTH. TO CONST. Existing System Inspection by: STEVE HEDRICK date 6-7-97

Installed by: A-1 Backhoe

~~Certificate of Completion by:~~ ____ date ____

Operation Permit by: [signature] date 6-23-97

HEALTH DEPT. COPY: WHITE INSPECTION COPY (FINAL): GREEN OWNER COPY (FINAL): YELLOW INSPECTION COPY (INITIAL): PINK OWNER COPY (INITIAL): GOLD