IREDELL COUNTY HEALTH DEPARTMENT

STATESVILLE 704-878-5305 MOORESVILLE 704-664-5281

IMPROVEMENT PERMIT / AUTHORIZATION TO CONSTRUCT / OPERATION PERMIT / EXISTING SYSTEM INSPECTION

PERMIT# 102001 PIN# 4705-38-7368.B DATE 10-2-01

OWNER OR CONTRACTOR KA YANG PHONE: Business Home (704) 528-0521

ADDRESS 125 IVEY OSTWALT RD, STATESVILLE NC 28677

LOCATION US 64 W, TL LIPPARD FARM, TR HAPPY ACRES TL TRAILWAY, BEAR LEFT, TL JANET, LOT ON (L) AT END

SUBDIVISION _____ BLOCK / SECTION _____ LOT B LOT AREA 1.0 ACRE SITE CLASS PS DESIGN FLOW 360 L.T.A.R. 0.20 APP/FT²

Septic Tank: 1000 Gallons: STB 1012 Date 7-27-01
Pump Tank: _____ Gallons: PT _____ Date _____
Pump Make: _____ Model _____ Serial No. _____
Nitrification Field: No Fields 1 Square Feet 1800 Linear Feet 450
No Lines FIVE Trench Width 36" Max Trench Bottom Depth 24" Gravel Depth N/A

☑ New System ☐ Repair System Type: I, II, (III), IV, V, VI
System Description: 25% REDUCTION GRAVITY
Repair System Description: LOW PRESSURE PIPE
Maintenance Agreement Required: ☐ Yes ☑ No (RECOMMENDED)


☐ House/Mod. Home ☑ Mobile Home ☐ Business ☐ Other
No. Bedrooms 3 No. Bathrooms 2 No. Employees _____
☐ Slab ☑ Crawl Space ☐ Basement w/plumbing ☐ Basement wo/plumbing

Water Supply: ☐ Individual ☑ Public ☐ Community


Comments/Conditions: (1) INSTALL SUBSURFACE INTERCEPT DRAINAGE DITCH AT LOCATION SHOWN BEGINNING 48" DEEP, AROUND SYSTEM, THEN OUT TO DAYLIGHT (2) INSTALL 25% REDUCTION SYSTEM USING 75 CHAMBERS OR 45 HDS SECTIONS.

Comments/Conditions: SEPTIC TANK WITH MARKER INSTALLED USING "POLYLOK" FILTER

INITIAL SITE SKETCH

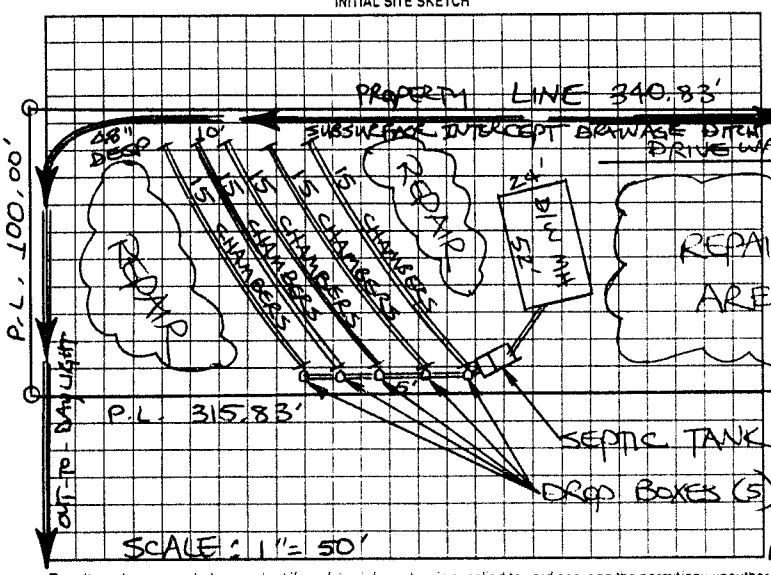

AS BUILT SKETCH

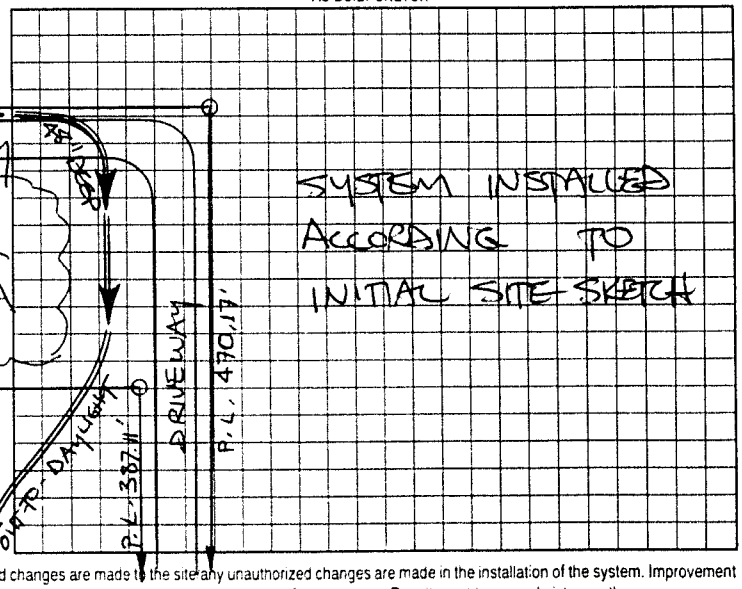

Permit can be suspended or revoked if any false information is supplied toward securing the permit; any unauthorized changes are made to the site; any unauthorized changes are made in the installation of the system. Improvement Permit with plat valid without expiration. Improvement Permit with site plan valid for sixty months. Authorization to Construct is valid for a period equal to that of Improvement Permit – not to exceed sixty months.

Signed: _____ date 10-2-01 Installed by: STATESVILLE BACKHOE

Improvement Permit by: STEVE HEDRICK date 10-2-01 Operation Permit by: STEVE HEDRICK date 10-30-01

Authorization to Construct by: STEVE HEDRICK date 10-2-01 Existing System Inspection by: _____ date _____

HEALTH DEPT COPY WHITE OWNER COPY (FINAL) YELLOW OWNER COPY (INITIAL) PINK