IREDELL COUNTY HEALTH DEPARTMENT

Statesville Office (704) 878-5305 Mooresville Office (704) 660-3625 PERMIT # 215577

IMPROVEMENT PERMIT / AUTHORIZATION TO CONSTRUCT / OPERATION PERMIT / EXISTING SYSTEM

PIN # 4705 394 168

APPLICANT: Kaying Lor APPLICANT ADDRESS: 603 12TH ST. Hickory NC 28602

SITE ADDRESS: 139 Rick Field Dr.; Statesville NC 28625 PHONE: 828-464-8870 ALT. PHONE: 715-222-8760

SITE DIRECTIONS: 40 W, Exit 148, TR Hwy 64, TL Linwood Farm, TR Happy Acres, TL Trailway, TL Talbott


SUBDIVISION: Casa Grande SECTION: 3 LOT # 13 LOT AREA: 10.024 Acre DESIGN FLOW: 360 GPD. L.T.A.R.: .275 I / .225 R

Septic Tank 1000 (gal)	STB 160	Date 5/20/16	☒ New System ☐ Repair ☐ Expansion	System Type: I II (III) IV V VI	☒ Residence	No. Bedrooms 3	Water Supply
Pump Tank (gal)	PT	Date	System Description: 25% Reduction - Gravity		☐ Business	No. Persons 6	☒ Private
Pump Make	Model	Serial #	Repair System Description: Same		☐ Other	No. Employees	☐ Public
# Nitrification Fields 1	# Lines 3 @ 109'	Linear Ft: 330'	Maintenance Agreement Required: ☐ YES ☒ NO		☐ Slab	☒ Crawl Space	☐ Community
Trench Width 36"	Max. Trench Bottom Depth 24" Lowside	Gravel Depth N/2	☒ GRAVITY ☐ PRESSURE		☐ Basement w/plumbing	☐ Basement w/o plumbing	


Comments / Conditions: Cut / Remove High Area And Direct Any Drainage Around Septic Area. Remove Burn In Septic Repair Area. Maintain 10' From Building Structures w/ Septic.

* Deed Must Be Recorded Prior To AC Issuance *

INITIAL SITE SKETCH

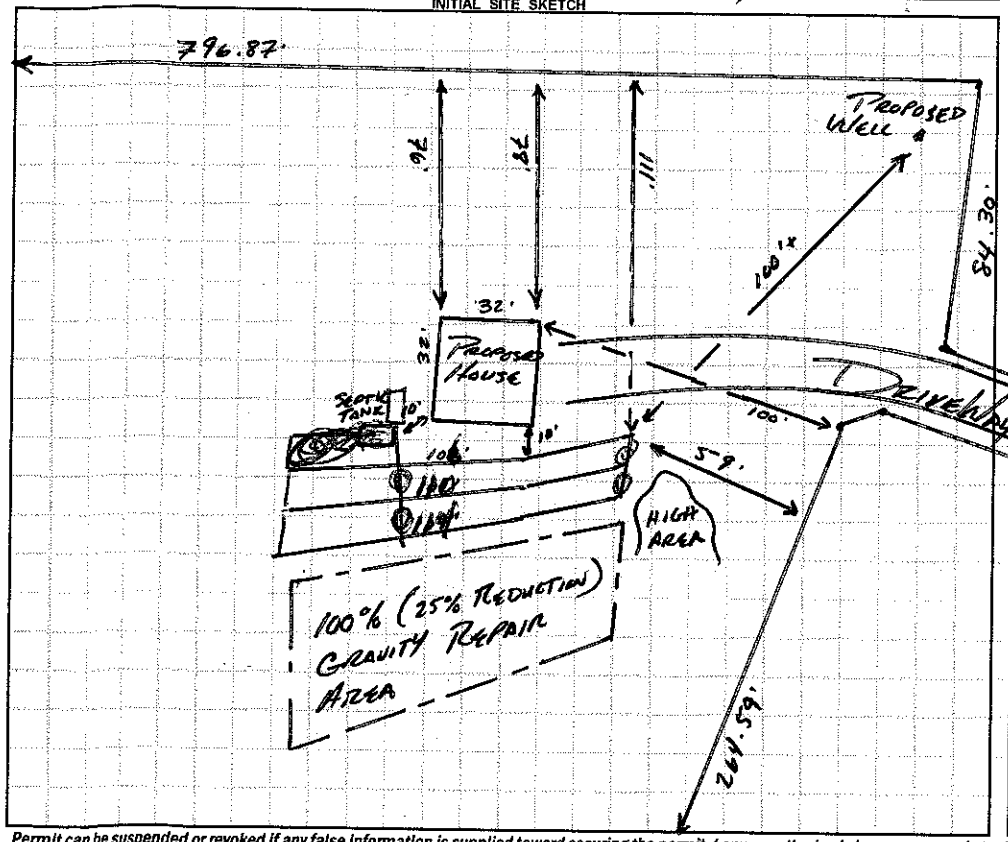

AS BUILT SKETCH

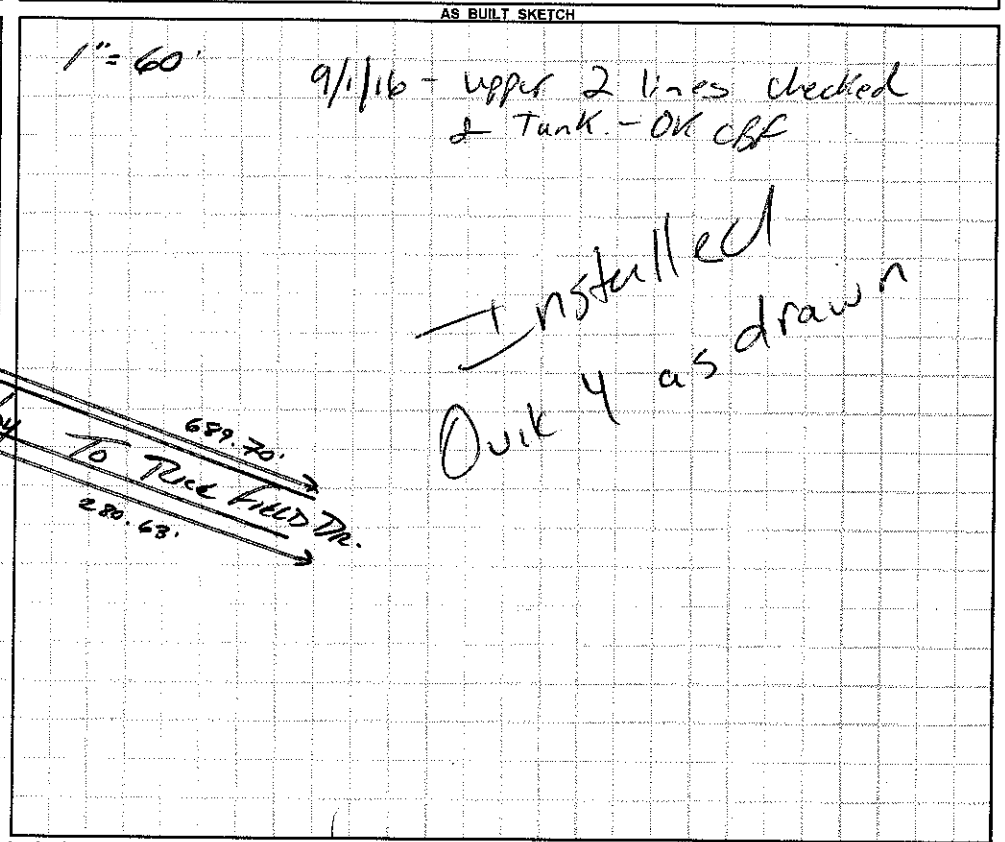

Permit can be suspended or revoked if any false information is supplied toward securing the permit / any unauthorized changes are made to the site / any unauthorized changes are made in the installation of the system. **CONTACT A LOCATOR SERVICE PRIOR TO ANY EXCAVATION**

☐ **IMPROVEMENT PERMIT** *with plat valid without expiration.* ☒ **IMPROVEMENT PERMIT** *with site plan valid for 60 mos.* ☒ **AUTHORIZATION TO CONSTRUCT** *valid for period equal to IMPROVEMENT PERMIT--not to exceed 60 mo.*

Owner / Applicant Signature: Date: 2-1-16 Installed by: Shane Jarrett Grading

IMPROVEMENT PERMIT by: APPROVED Date: JAN 27 2016 OPERATION PERMIT by: Date: 09/06/16

AUTHORIZATION TO CONSTRUCT by: Date: 05/10/16 Existing System Inspected by: Date:

Health Dept. Copy - WHITE Applicant (Final Approval) - YELLOW Applicant (Conditional Approval) - PINK