IREDELL COUNTY HEALTH DEPARTMENT

STATESVILLE 704-878-5305 MOORESVILLE 704-664-5281

IMPROVEMENT PERMIT / AUTHORIZATION TO CONSTRUCT / OPERATION PERMIT / EXISTING SYSTEM INSPECTION

PERMIT# ~~8771~~ 118904 PIN# 4705406~~093~~ 1703 DATE June 12 2000

OWNER OR CONTRACTOR Heritage Building PHONE: Business 528-6644 Home

ADDRESS 120 Hickory Point Ct Statesville

LOCATION Hwy 40W (R) Old NC Rd (R) Alpine Circle on Left past 1st Street

SUBDIVISION Alexander Knoll BLOCK / SECTION LOT 26 LOT AREA .56 Ac SITE CLASS. PS DESIGN FLOW 360 L.T.A.R. .3

Septic Tank: 1000 Gallons; STB 1612 Date 11-23-03
Pump Tank: Gallons; PT Date
Pump Make: Model Serial No.
Nitrification Field: No Fields 1 Square Feet 1200 ~~Linear Feet~~ CRTA 300
No Lines 4 Trench Width 36" Max Trench Bottom Depth 36" Gravel Depth N/A

☒ New System ☐ Repair System Type: I, II, (III) IV, V, VI
System Description: Gravity - 25% Reduction
Repair System Description: Pump Reduction
Maintenance Agreement Required: ☐ Yes ☒ No

☒ House/Mod. Home No. Bedrooms 3
☐ Mobile Home No. Bathrooms 2
☐ Business No. Employees
☐ Other


☐ Slab ☒ Crawl Space ☐ Basement w/plumbing ☐ Basement wo/plumbing

Water Supply: ☐ Individual ☒ Public ☐ Community

Comments:/Conditions: 50 chamber or ~~30~~ 30 HDS sections
Install on Contour May use D-Box w/ speed Levels

Comments:/Conditions: Taff Tee filter + ST marker Installed
- Infiltrator chambers Installed (48) = 300 ft
- Installed drop boxes (4 @ 75 Lin ft)

INITIAL SITE SKETCH PC 261.44

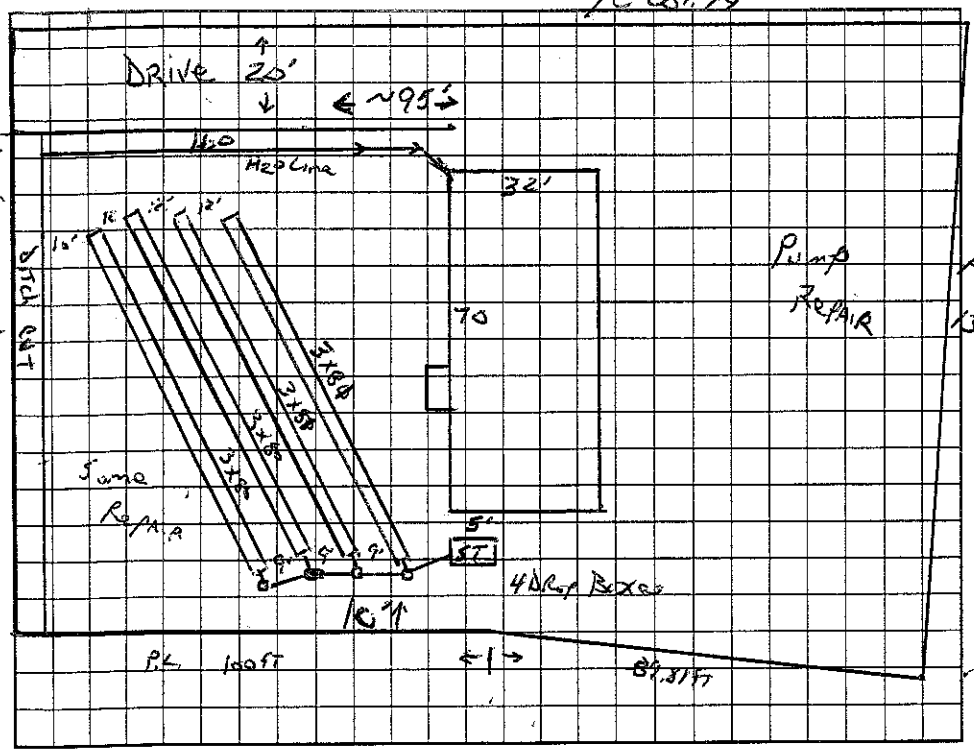

AS BUILT SKETCH

Installed As Shown per Initial Site Sketch

Permit can be suspended or revoked if any false information is supplied toward securing the permit/any unauthorized changes are made to the site/any unauthorized changes are made in the installation of the system. Improvement Permit with ~~plat~~ valid without expiration. Improvement Permit with site plan valid for sixty months. Authorization to Construct is valid for a period equal to that of Improvement Permit – not to exceed sixty months.

Signed: date 7-13-00 Installed by: Tommy Frye

Improvement Permit by: Jo Potter date June 12 2000 Operation Permit by: William O. Johnson date 5/21/04

Authorization to Construct by: Jo Potter date June 12 2000 Existing System Inspection by: date

HEALTH DEPT. COPY: WHITE OWNER COPY (FINAL): YELLOW OWNER COPY (INITIAL): PINK