IREDELL COUNTY HEALTH DEPARTMENT

STATESVILLE 704-878-5305 MOORESVILLE 704-664-5281

IMPROVEMENT PERMIT / CERTIFICATE OF COMPLETION / OPERATION PERMIT / EXISTING SYSTEM INSPECTION

PROPERTY DESCRIPTION NO. 25495 DATE 11-5-96 TAX MAP NO. 8 T-4-A-4

OWNER OR CONTRACTOR Glen Jenkins PHONE: Business Home 878 0976 Watershed: ☐ Yes ☑ No

ADDRESS 90 317 Grassy Knob Rd LOCATION 64 West TR Lippard TR massy Deal Rd Union Grove 1/4 mi on rt

SUBDIVISION Flat Pike BLOCK / SECTION LOT 9 LOT AREA 1.684 acres SITE CLASS. 1 & 5 DESIGN FLOW 360 L.T.A.R. .39 gal/SF/day

Septic Tank: 1000 Gallons; STB 794 Date 2-20-97

Pump Tank: Gallons; PT Date

Pump Make: Model Serial No.

Nitrification Field: No Fields I Square Feet 1200 Linear Feet 400

No Lines 3 Trench Width 36" Max Trench Bottom Depth 36" Gravel Depth 12"

☑ New System ☐ Repair System Type: I, II, III, IV, V, VI

System Description: Conv. Gravity

Repair System Description: " "

Maintenance Agreement Required: ☐ Yes ☑ No

☑ House/Mod. Home No. Bedrooms 3

☐ Mobile Home No. Bathrooms 2

☐ Business No. Employees

☐ Other


☐ Slab ☐ Crawl Space ☑ Basement w/plumbing ☐ Basement wo/plumbing

Water Supply: ☐ Individual ☐ Community ☑ Public


Comments:

Comments:

INITIAL SITE SKETCH

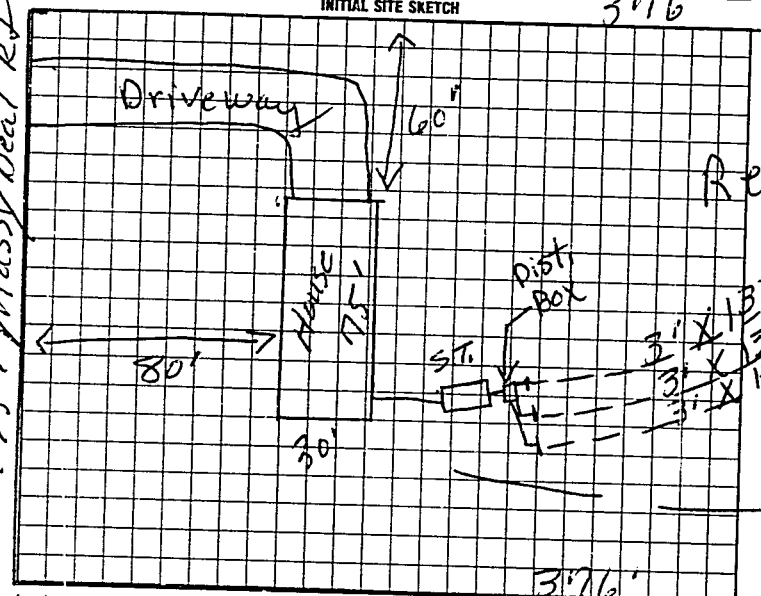

AS BUILT SKETCH

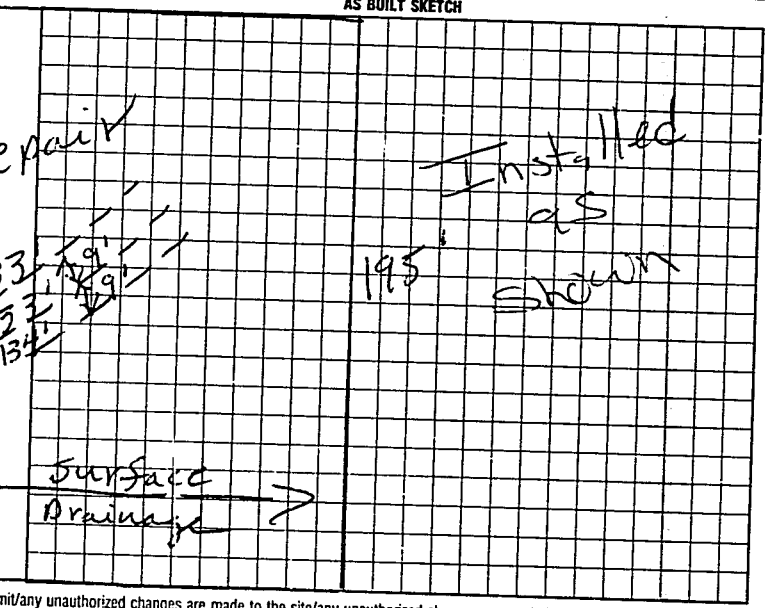

I understand that this permit can be suspended or revoked if any false information is supplied toward securing the permit/any unauthorized changes are made to the site/any unauthorized changes are made in the installation of the system.

Signed: X

Improvement Permit by: E.C. Moore date 11-5-96

~~Existing System Inspection by~~ Authorization to Construct by: E.C. Moore date 11-5-96

Installed by: James Huddleston

Certificate of Completion by:

Operation Permit by: date 4-15-97

Authorization to Construct Expires 6 mos from issue

WHITE COPY (FINAL) GREEN INSPECTION COPY (FINAL) YELLOW OWNER COPY (FINAL) YELLOW INSPECTION COPY (INITIAL) PINK OWNER COPY (INITIAL) GOLD