THIS PERMIT VOIDS PERMIT ISSUED on 10-28-11

IREDELL COUNTY HEALTH DEPARTMENT - *ENVIRONMENTAL HEALTH* ☒ STATESVILLE OFFICE 704-878-5305 ☐ MOORESVILLE OFFICE 704-664-5281

IMPROVEMENT PERMIT / AUTHORIZATION TO CONSTRUCT / OPERATION PERMIT / EXISTING SYSTEM INSPECTION

PERMIT # 168932 PIN # 4705-44-0000 DATE 1-5-12

OWNER Shannon Osbourne APPLICANT: America's Home Place PHONE: Home/Cell # 704-872-4400 Business # 828-779-2303

SITE ADDRESS 367 Massey Dead Road OWNER / APPLICANT ADDRESS 1206 Greenland Drive, Statesville

SITE DIRECTIONS 64W to Lippard Farm T/L go 1 mile, T/R on Massey Dead, ½ mile on (R)

SUBDIVISION n/a BLOCK / SECTION n/a LOT # LOT AREA .76 Ac. DESIGN FLOW 480 L.T.A.R. .3

Septic Tank 1000 Gallons: STB 760 Date 6-20-11
Pump Tank Gallons: P T Date
Pump Make Model Serial #
No. Nitrification Fields: 1 No. Lines 8 Linear Feet 400
Trench Width 36" Max. Trench Bottom Depth 36" Gravel Depth n/a


☒ New System ☐ Repair ☐ Expansion System Type I II (III) IV V VI
System Description: 25% Reduction Gravity
Repair System Description: 50% Reduction Gravity
Maintenance Agreement Required ☐ YES ☒ NO
☒ GRAVITY ☐ PRESSURE

☒ Residence No. Bedrooms 4
☐ Business No. Persons
☐ Other No. Employees
☐ Slab ☐ Crawl Space
☐ Basement w/plumbing ☒ Basement w/o plumbing


Water Supply: ☐ Private ☒ Public ☐ Community

Comments / Conditions

INITIAL SITE SKETCH

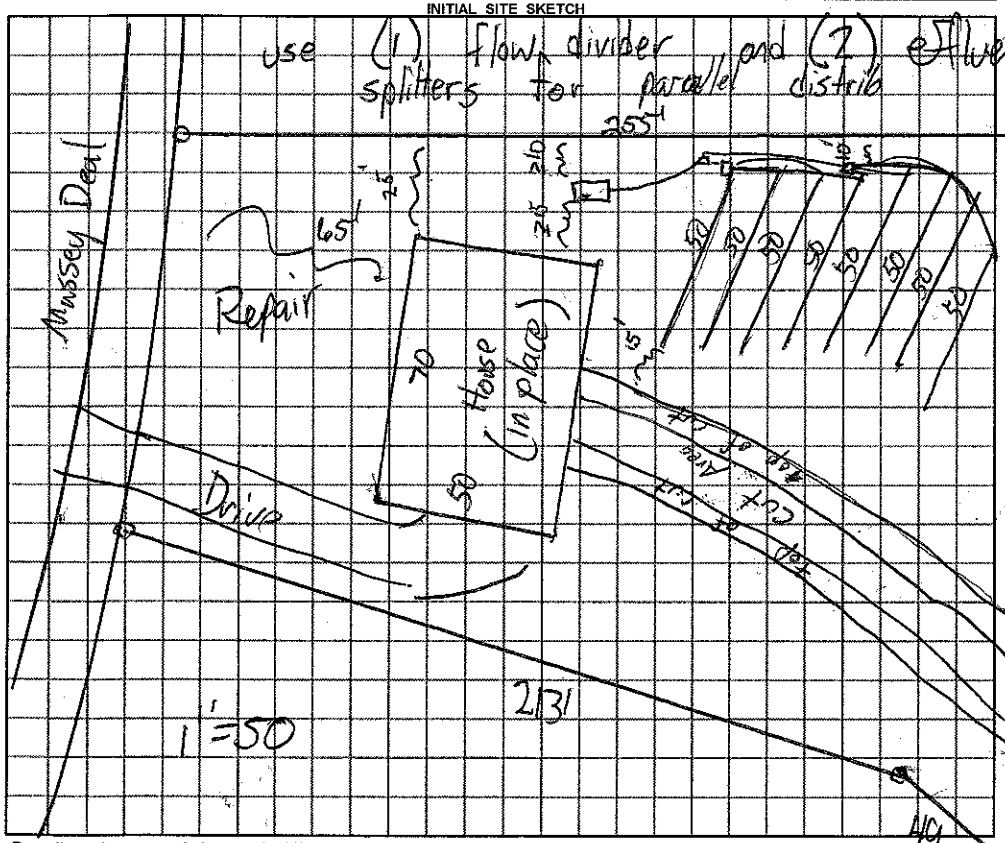

AS BUILT SKETCH

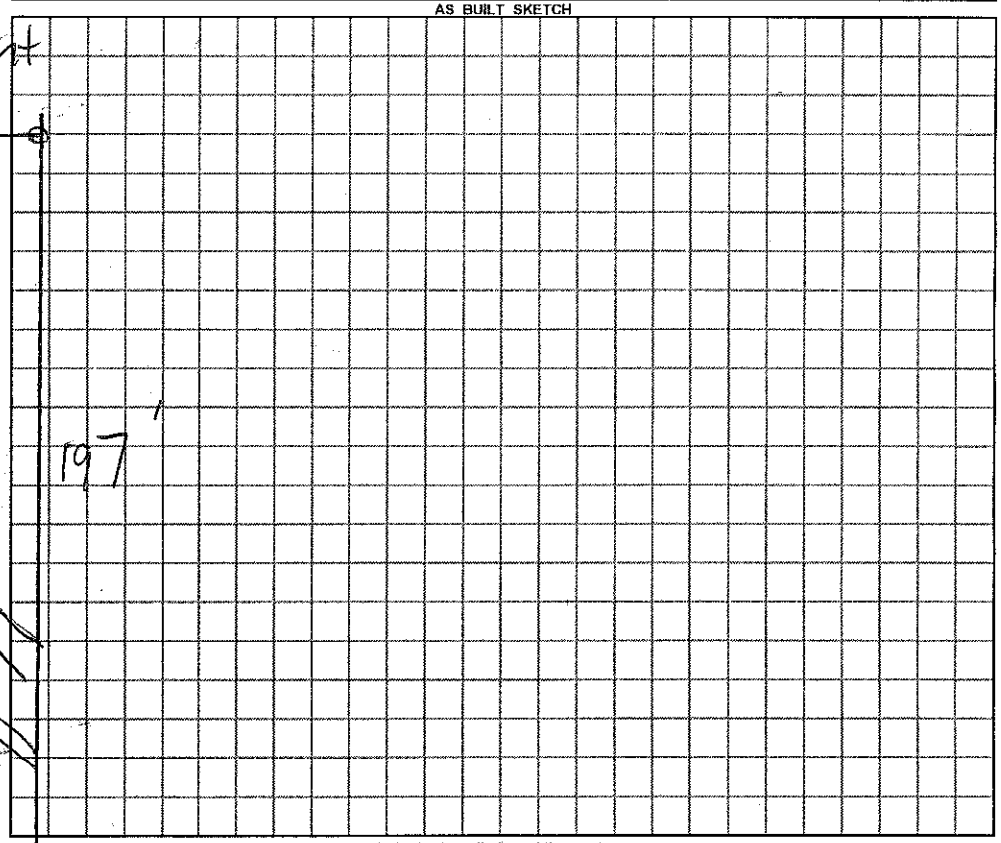

Permit can be suspended or revoked if any false information is supplied toward securing the permit / any unauthorized changes are made to the site / any unauthorized changes are made in the installation of the system.

☐ ***IMPROVEMENT PERMIT*** with plat valid without expiration. ☒ ***IMPROVEMENT PERMIT*** with plat valid without expiration. site plan valid 60 mo. ☒ ***AUTHORIZATION TO CONSTRUCT*** valid for period equal to IMPROVEMENT PERMIT--not to exceed 60 mo.

Owner / Applicant Signature: Date 1-9-12 Installed by: Groundbreakers

IMPROVEMENT PERMIT by: REHS Date 1-5-12 OPERATION PERMIT by: REHS Date 1-10-12

AUTHORIZATION TO CONSTRUCT by: REHS Date 1-5-12 Existing System Inspected by: REHS Date

YOU SHOULD CONTACT A LOCATOR SERVICE PRIOR TO ANY EXCAVATION

White Copy – Environmental Health YELLOW COPY (Final) Owner / Applicant PINK COPY (Initial) Owner / Applicant