**IREDELL COUNTY HEALTH DEPARTMENT - *ENVIRONMENTAL HEALTH*** ☐ STATESVILLE OFFICE 704-878-5305 ☐ MOORESVILLE OFFICE 704-664-5281

**IMPROVEMENT PERMIT / AUTHORIZATION TO CONSTRUCT / OPERATION PERMIT / EXISTING SYSTEM INSPECTION**

PERMIT # 175750 PIN # 4705-44-2000 DATE NOVEMBER 1, 2012

OWNER SCOT & DIANE OSBORNE APPLICANT: SAME PHONE: Home/Cell # 704-838-0163 Business # 704-450-5688

SITE ADDRESS 377 MASSEY DEAL ROAD OWNER / APPLICANT ADDRESS SAME

SITE DIRECTIONS US 64 WEST, TL LIPPARD FARM RD, TR MASSEY DEAL ROAD, ON R@ # 377.

SUBDIVISION N/A BLOCK / SECTION N/A LOT # N/A LOT AREA 2 ACRES DESIGN FLOW 360 L.T.A.R. 0.30 GPD/FT²

Septic Tank EXISTING Gallons: STB ____ Date ____

Pump Tank ____ Gallons: P T ____ Date ____

Pump Make ____ Model ____ Serial # ____

No. Nitrification Fields: 1 No. Lines 7 Linear Feet 300

Trench Width 36" Max. Trench Bottom Depth 36" Gravel Depth N/A

☐ New System ☑ Repair ☐ Expansion System Type I II (III) IV V VI

System Description: ____

Repair System Description: 25% REDUCTION, GRAVITY

Maintenance Agreement Required ☐ YES ☑ NO

☑ GRAVITY ☐ PRESSURE

☑ Residence No. Bedrooms 3

☐ Business No. Persons ____

☐ Other No. Employees ____


☐ Slab ☐ Crawl Space

☑ Basement w/plumbing ☐ Basement w/o plumbing


Water Supply: ☐ Private ☑ Public ☐ Community

Comments / Conditions: INSTALL NEW 25% REDUCTION SYSTEM ON CONTOUR AS FLAGGED, AS SHALLOW AS POSSIBLE. REPLACE EXISTING SEPTIC TANK IF NECESSARY.

INITIAL SITE SKETCH

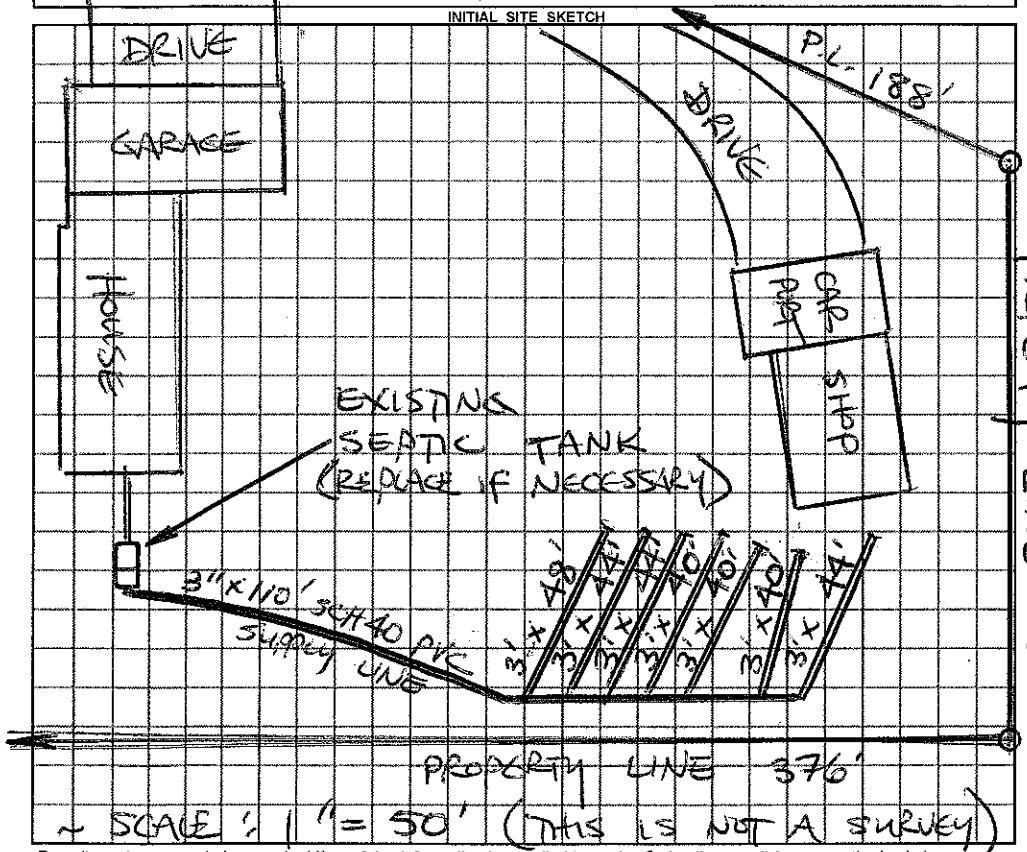


AS BUILT SKETCH

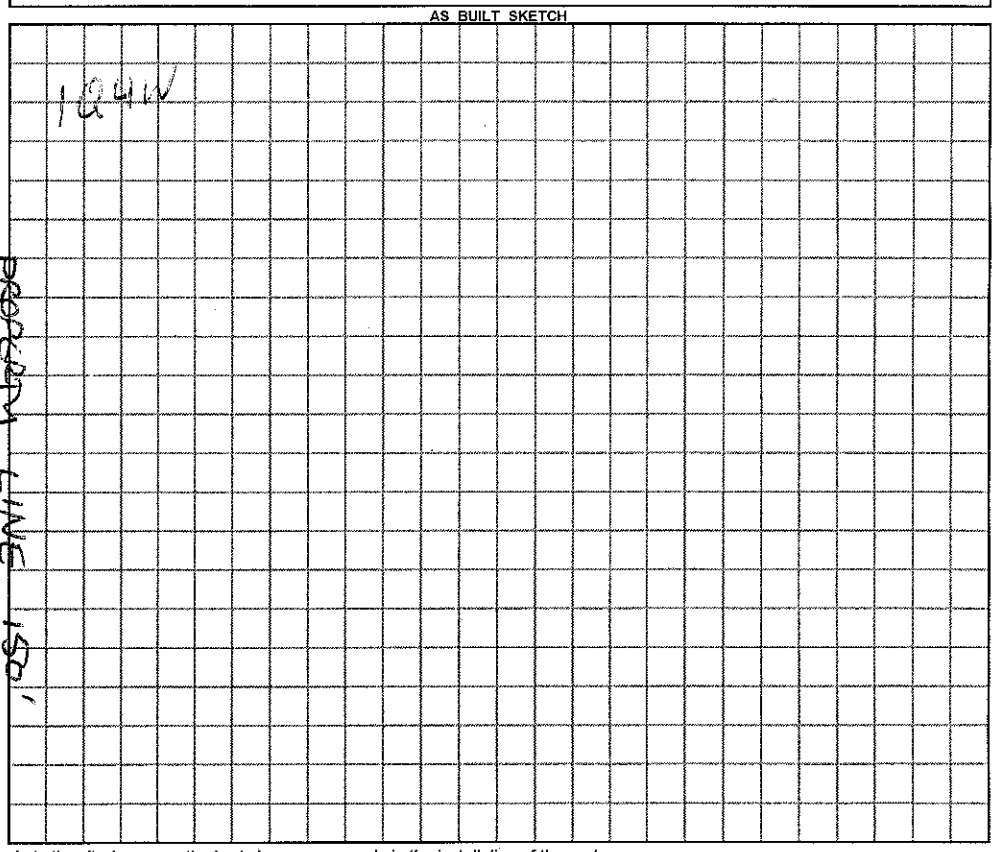


*Permit can be suspended or revoked if any false information is supplied toward securing the permit / any unauthorized changes are made to the site / any unauthorized changes are made in the installation of the system.*

☐ ***IMPROVEMENT PERMIT*** with plat valid without expiration. ☑ ***IMPROVEMENT PERMIT*** with plat valid without expiration. Site plan valid 60 mo. ☑ ***AUTHORIZATION TO CONSTRUCT*** valid for period equal to IMPROVEMENT PERMIT--not to exceed 60 mo.

Owner / Applicant Signature: ____ Date 11/1/12 Installed by: Rowan Septic

IMPROVEMENT PERMIT by: STEVE HEDRICK REHS Date 11/1/12 OPERATION PERMIT by: ____ REHS Date 11/14/12

AUTHORIZATION TO CONSTRUCT by: STEVE HEDRICK REHS Date 11/1/12 Existing System Inspected by: ____ REHS Date ____

***YOU SHOULD CONTACT A LOCATOR SERVICE PRIOR TO ANY EXCAVATION***

White Copy – Environmental Health YELLOW COPY (Final) Owner / Applicant PINK COPY (Initial) Owner / Applicant