IREDELL COUNTY HEALTH DEPARTMENT

STATESVILLE 704-878-5305 MOORESVILLE 704-664-5281

IMPROVEMENT PERMIT / CERTIFICATE OF COMPLETION / OPERATION PERMIT / EXISTING SYSTEM INSPECTION

PROPERTY DESCRIPTION NO. 0665444 DATE 5-31-97 TAX MAP NO. 4705476919

OWNER OR CONTRACTOR ERNEST RUNGE PHONE: Business Home 872-6645 Watershed: ☐ Yes ☑ No

ADDRESS 379 LONG ISLAND ROAD STATESVILLE, NC 28677

LOCATION US 64 W TL LIPPARD FARM RD TR HAPPY ACRES TL TRAILWAY DR, 1ST LOT ON LEFT

SUBDIVISION CASA GRANDE BLOCK / SECTION II LOT 11 LOT AREA 26,545 SF SITE CLASS. PS1 DESIGN FLOW 360 L.T.A.R. 0.30 GPD/FT²

Septic Tank: 1000 Gallons; STB 821 Date 10-8-97

Pump Tank: _____ Gallons; PT _____ Date _____

Pump Make: _____ Model _____ Serial No. _____

Nitrification Field: No Fields 1 Square Feet 1200 Linear Feet 400

No Lines SEVEN Trench Width 36" Max Trench Bottom Depth 36" Gravel Depth 12"

☑ New System ☐ Repair System Type: I, (II), III, IV, V, VI

System Description: CONVENTIONAL GRAVITY

Repair System Description: PPBPS, PUMP/GRAVITY

Maintenance Agreement Required: ☐ Yes ☑ No

☐ House/Mod. Home No. Bedrooms 3

☑ Mobile Home No. Bathrooms 2

☐ Business No. Employees ____

☐ Other _____

☐ Slab ☑ Crawl Space ☐ Basement w/plumbing ☐ Basement wo/plumbing


Water Supply: ☐ Individual ☐ Community ☑ Public

Comments:

Comments:

* site set for D/W 3Bd M/H

INITIAL SITE SKETCH

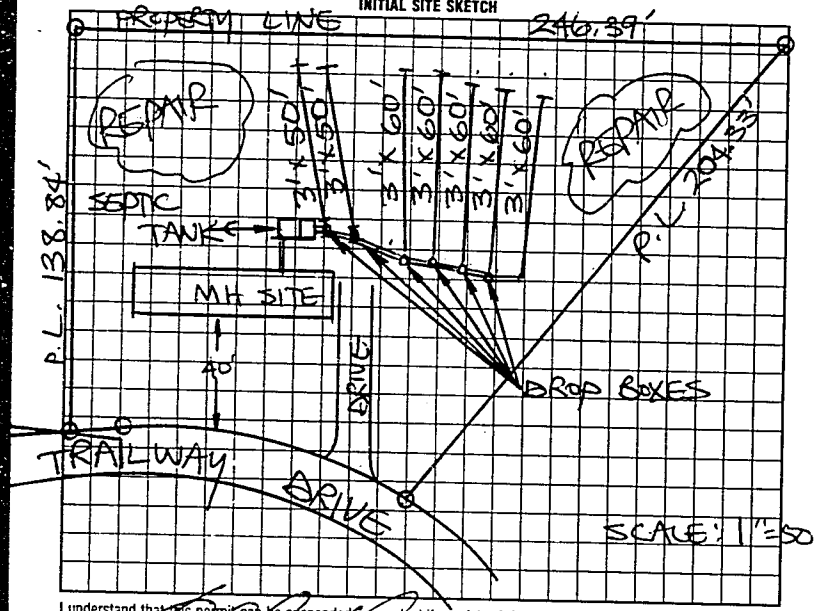

AS BUILT SKETCH

Installed as shown

I understand that this permit can be suspended or revoked if any false information is supplied toward securing the permit/any unauthorized changes are made to the site/any unauthorized changes are made in the installation of the system. Improvement Permit is valid for 60 months from date of issuance. AUTHORIZATION TO CONSTRUCT IS VALID FOR 60 MONTHS FROM DATE OF ISSUANCE.

Signed: _____

Improvement Permit by: STEVE HEDRICK date 5-31-97 (AUTH. TO CONST.)

Existing System Inspection by: STEVE HEDRICK date 5-31-97

Installed by: G & M Enterprises

~~Certificate of Completion by:~~ _____ date _____

Operation Permit by: Mat Cuffs date 11-7-97

HEALTH DEPT COPY WHITE | INSPECTION COPY (FINAL) GREEN | OWNER COPY (FINAL) YELLOW | INSPECTION COPY (INITIAL) PINK | OWNER COPY (INITIAL) GOLD

0021453