IREDELL COUNTY HEALTH DEPARTMENT

THIS PERMIT VOIDS PREVIOUS ISSUED 4-25-98

STATESVILLE 704-878-5305 MOORESVILLE 704-664-5281

IMPROVEMENT PERMIT / AUTHORIZATION TO CONSTRUCT / OPERATION PERMIT / EXISTING SYSTEM INSPECTION

PERMIT# 072391 PIN# 4705 47 3956 DATE 4-21-99

OWNER OR CONTRACTOR ERNEST RUNGE PHONE: Business _____ Home 872-6645

ADDRESS 374 LONG ISLAND ROAD, STATESVILLE, NC 28677

LOCATION US 64 W, TL LIPPARD FARM RD, TR HAPPY ACRES, TL TRAILWAY DRIVE, BEAR RIGHT, 14th LOT ON LEFT

SUBDIVISION CASA GRANDE BLOCK / SECTION II LOT 27 LOT AREA 20,250 SF SITE CLASS PS DESIGN FLOW 360 L.T.A.R. 0.30 GPD/FT2

Septic Tank: 1000 Gallons: STB 1012 Date 3-6-99

Pump Tank: _____ Gallons; PT _____ Date _____

Pump Make: _____ Model _____ Serial No. _____

Nitrification Field: No Fields 1 Square Feet 1200 Linear Feet 400

No Lines FOUR Trench Width 36" Max Trench Bottom Depth 36" Gravel Depth 12"

☑ New System ☐ Repair System Type: I (II) III IV V VI

System Description: CONVENTIONAL GRAVITY

Repair System Description: 25% REDUCTION GRAVITY

Maintenance Agreement Required: ☐ Yes ☑ No

☐ House/Mod. Home ☐ Mobile Home ☐ Business ☐ Other

No. Bedrooms 3 No. Bathrooms 2 No. Employees _____


☐ Slab ☑ Crawl Space ☐ Basement w/plumbing ☐ Basement wo/plumbing

Water Supply: ☐ Individual ☑ Public ☐ Community

Comments/Conditions: CONSTRUCT SURFACE DIVERSION DRAINAGE DITCH AT LOCATION SHOWN

Comments/Conditions:

INITIAL SITE SKETCH SCALE: 1"=40'

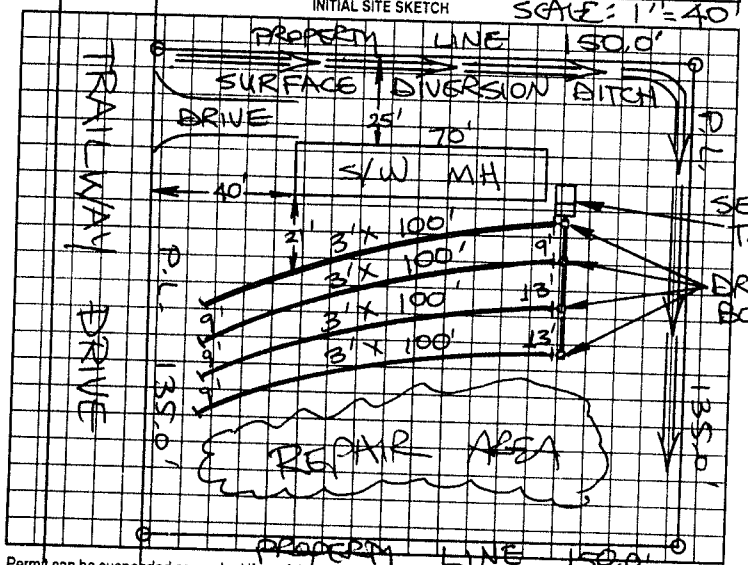

AS BUILT SKETCH

Installed as shown

Permit can be suspended or revoked if any false information is applied toward securing the permit/any unauthorized changes are made to the site/any unauthorized changes are made in the installation of the system. Improvement Permit with plat valid without expiration. Improvement Permit with site plan valid for sixty months. Authorization to Construct is valid for a period equal to that of Improvement Permit – not to exceed sixty months.

Signed: _____ date _____

Improvement Permit by: STEVE HEDRICK date 4-21-99

Authorization to Construct by: STEVE HEDRICK date 4-21-99

Installed by: A-1 Backhoe

Operation Permit by: Mark C. Ott RS date 4-27-99

Existing System Inspection by: _____ date _____

HEALTH DEPT. COPY: WHITE OWNER COPY (FINAL) YELLOW OWNER COPY (INITIAL) PINK