IREDELL COUNTY HEALTH DEPARTMENT

STATESVILLE 704-878-5305 MOORESVILLE 704-664-5281

IMPROVEMENT PERMIT / CERTIFICATE OF COMPLETION / OPERATION PERMIT / EXISTING SYSTEM INSPECTION

PROPERTY DESCRIPTION NO. 70445 DATE 12-3-97 TAX MAP NO. 4705 48 2795 PT Watershed: ☐ Yes ☐ No

OWNER OR CONTRACTOR Ernest Runge PHONE: Business Home 872 6645

ADDRESS 374 Long Island Rd Statesville, N.C.

LOCATION 64' W TL Lippart Fm Rd TR Happy acres TL railway TR Tangent at end

SUBDIVISION Casa Grande BLOCK / SECTION III LOT 1 LOT AREA 5 acres SITE CLASS. PS DESIGN FLOW 480 L.T.A.R. .3

Septic Tank: 1000 Gallons; STB 1012 Date 10-17-97
Pump Tank: Gallons; PT Date
Pump Make: Model Serial No.
Nitrification Field: No Fields 1 Square Feet 1600 Linear Feet 533
No Lines 4 Trench Width 36" Max Trench Bottom Depth 36" Gravel Depth 12"

☑ New System ☐ Repair System Type: I, II, III, IV, V, VI
System Description: conv. Gravity
Repair System Description: II 21
Maintenance Agreement Required: ☐ Yes ☑ No

☐ House/Mod. Home No. Bedrooms 4
☑ Mobile Home No. Bathrooms 2
☐ Business No. Employees
☐ Other


☐ Slab ☑ Crawl Space ☐ Basement w/plumbing ☐ Basement wo/plumbing

Water Supply:
☐ Individual
☐ Community
☑ Public


Comments:

Comments: Same as initial Sketch

INITIAL SITE SKETCH

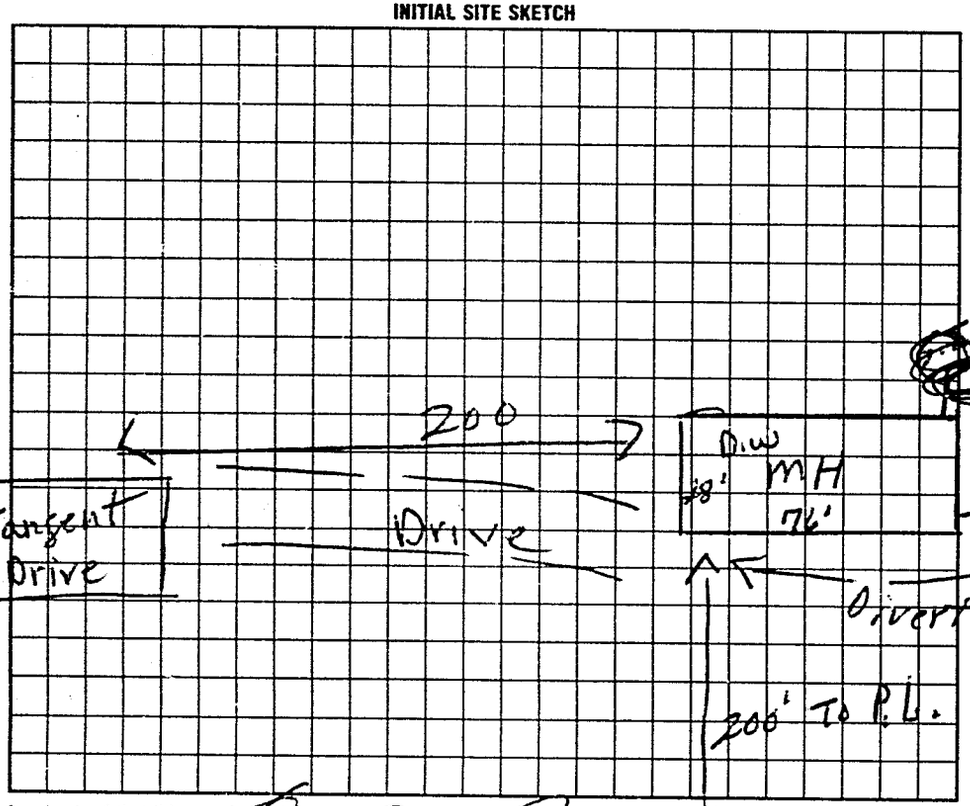

AS BUILT SKETCH

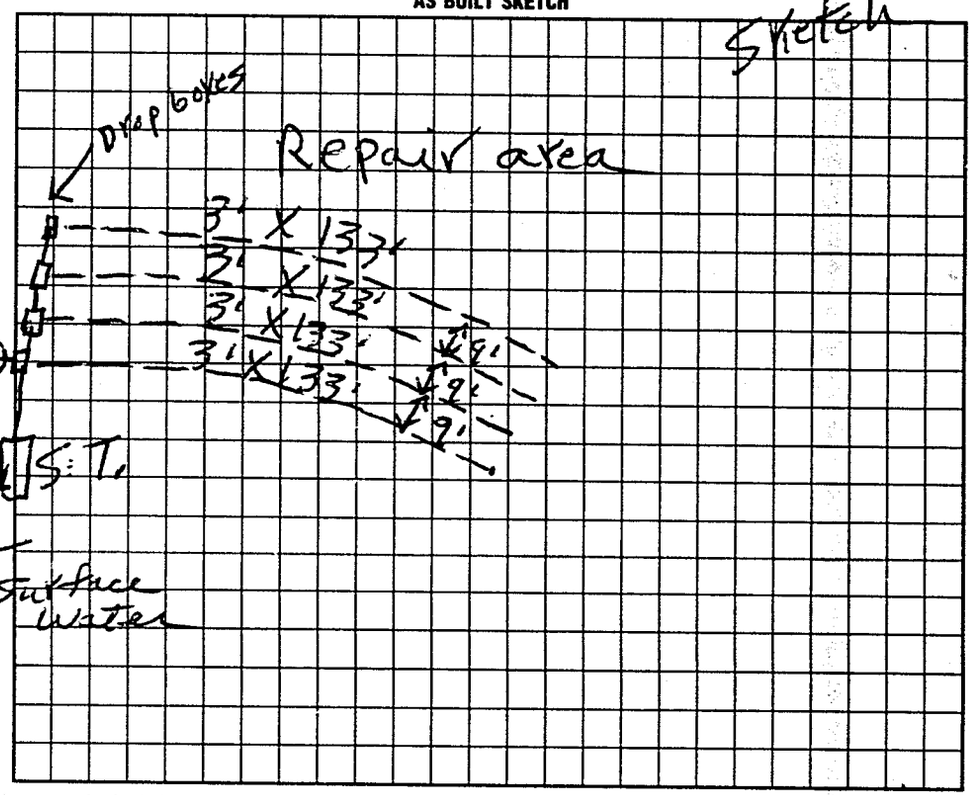

I understand that this permit can be suspended or revoked if any false information is supplied toward securing the permit/any unauthorized changes are made to the site/any unauthorized changes are made in the installation of the system. Improvement Permit is valid for 60 months from date of issuance.

Signed:

Improvement Permit by: P. C. moore date 12-3-97

Authorization to Install Existing System Inspection by P. C. moore date 12-3-97

Installed by: Donald Tacker

Certificate of Completion by: date

Operation Permit by P. C. moore date 2-2-98

Authorization to Cover: Authorization to cover EXPIRES 60 MOS FROM ISSUE

HEALTH DEPT COPY WHITE | INSPECTION COPY (FINAL): GREEN | OWNER COPY (FINAL): YELLOW | INSPECTION COPY (INITIAL): PINK | OWNER COPY (INITIAL): GOLD

9 8 7 8 0