IREDELL COUNTY HEALTH DEPARTMENT

Statesville Office (704) 878-5305 Mooresville Office (704) 660-3625 PERMIT # 208414

IMPROVEMENT PERMIT / AUTHORIZATION TO CONSTRUCT / OPERATION PERMIT / EXISTING SYSTEM

PIN # 4705482142

APPLICANT: Ernest Runge APPLICANT ADDRESS: 374 Long Island Rd.

SITE ADDRESS: 192 Trailway Drive PHONE: 704-872-9562 ALT. PHONE: N/A

SITE DIRECTIONS: Hwy 64 W TL Lippard Farm Rd TR Happy Acres TL Trailway Dr.

SUBDIVISION: Casa Grande SECTION: 2 LOT # 16 LOT AREA: 0.46 acres DESIGN FLOW: 360 gpd L.T.A.R.: Existing

Septic Tank Existing (gal)	STB	Date	☐ New System ☐ Repair ☐ Expansion System Type: I II (III) IV V VI	☑ Residence	No. Bedrooms 3	Water Supply
Pump Tank (gal)	PT	Date	System Description: 25% Reduction	☐ Business	No. Persons 6	☐ Private
Pump Make	Model	Serial #	Repair System Description:	☐ Other	No. Employees	☑ Public
# Nitrification Fields Ex	# Lines Ex	Linear Ft: Ex	Maintenance Agreement Required: ☐ YES ☑ NO	☐ Slab	☑ Crawl Space	☐ Community
Trench Width Ex	Max. Trench Bottom Depth Ex	Gravel Depth Ex	☑ GRAVITY ☐ PRESSURE	☐ Basement w/plumbing	☐ Basement w/o plumbing	


Comments / Conditions:

Maintain a minimum of 5' between home foundation & all components of septic tank system.

INITIAL SITE SKETCH

Scale 1" = 40'

AS BUILT SKETCH

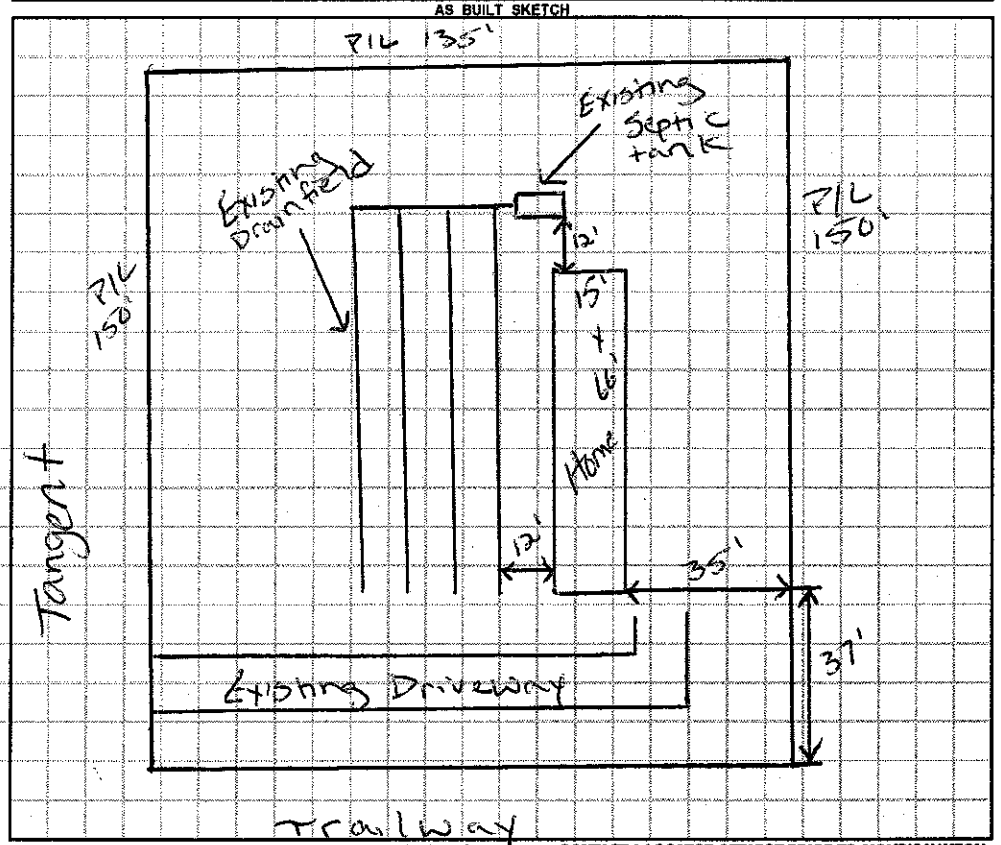

Permit can be suspended or revoked if any false information is supplied toward securing the permit / any unauthorized changes are made to the site / any unauthorized changes are made in the installation of the system. **CONTACT A LOCATOR SERVICE PRIOR TO ANY EXCAVATION**

☐ **IMPROVEMENT PERMIT** *with plat valid without expiration.* ☐ **IMPROVEMENT PERMIT** *with site plan valid for 60 mos.* ☐ **AUTHORIZATION TO CONSTRUCT** *valid for period equal to IMPROVEMENT PERMIT--not to exceed 60 mo.*

Owner / Applicant Signature: Ernest Runge Date: Installed by:

IMPROVEMENT PERMIT by: Date: OPERATION PERMIT by: Date:

AUTHORIZATION TO CONSTRUCT by: Date: Existing System Inspected by: Justin Mendenhall Date: 3-3-15

Health Dept. Copy - WHITE Applicant (Final Approval) - YELLOW Applicant (Conditional Approval) - PINK