IREDELL COUNTY HEALTH DEPARTMENT

THIS PERMIT VOIDS PREVIOUS ISSUED 11-15-97

STATESVILLE 704-878-5305 MOORESVILLE 704-664-5281

IMPROVEMENT PERMIT / AUTHORIZATION TO CONSTRUCT / OPERATION PERMIT / EXISTING SYSTEM INSPECTION

PERMIT# 070178 PIN# 4705 48 3157 DATE 12-9-98

OWNER OR CONTRACTOR ERNEST RUNGE PHONE: Business Home 872-6645

ADDRESS 374 LONG ISLAND ROAD STATESVILLE NC 28677

LOCATION US 64 W TL LIPPARD FARM, TR HAPPY ACRES, TL TRAILWAY, BEAR LEFT 2ND LOT ON LEFT PAST

SUBDIVISION CASA GRANDE BLOCK / SECTION II LOT 17 LOT AREA 17,964 SF SITE CLASS PS DESIGN FLOW 240 L.T.A.R. 0.30 GPD/FT²

Septic Tank: 1000 Gallons: STB 1012 Date 10-12-98

Pump Tank: Gallons: PT Date

Pump Make: Model: Serial No.

Nitrification Field: No Fields 1 Square Feet EQ. TO 800 Linear Feet 205+

No Lines THREE Trench Width 36" Max Trench Bottom Depth 36" Gravel Depth SAND 6"

☑ New System ☐ Repair System Type: I, II, III, IV, V

System Description: 25% REDUCTION SYSTEM

Repair System Description: PVC'S, LOW PRESSURE

Maintenance Agreement Required: Yes ☑ No

☐ House/Mod. Home ☑ Mobile Home ☐ Business Other 2 BEDROOM ONLY


No. Bedrooms 2 No. Bathrooms 2 No. Employees

Water Supply: ☐ Individual ☑ Public ☐ Community

Slab ☑ Crawl Space Basement w/plumbing Basement wo/plumbing

Comments/Conditions: INSTALL 25% REDUCTION SYSTEM USING THIRTY-SEVEN CHAMBERS (AT REQUEST)

SCALE: 1"=30'

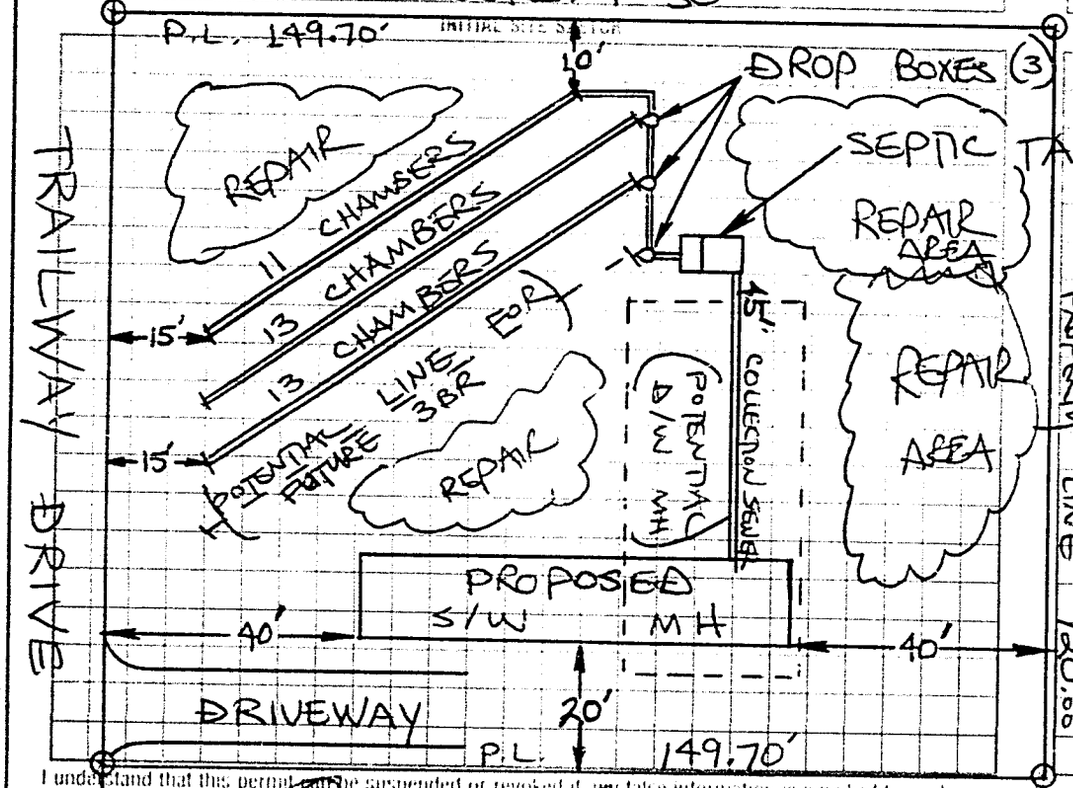

Comments/Conditions:

AS BUILT SKETCH

SYSTEM INSTALLED ACCORDING TO INITIAL SITE SKETCH

TANGENT DRIVE

I understand that this permit may be suspended or revoked if any false information is supplied toward securing the permit/any unauthorized changes are made to the site/any unauthorized changes are made in the installation of the system. Improvement Permit with plat valid without expiration. Improvement Permit with site plan valid for sixty months. Authorization to Construct is valid for a period equal to that of Improvement Permit – not to exceed sixty months.

Signed: date 10 Dec 98

Improvement Permit by: STEVE HEDACK date 12-9-98

Authorization to Construct by: STEVE HEDRICK date 12-9-98

Installed by: A-1 BACKHOE

Operation Permit by: STEVE HEDRICK date 12-18-98

Existing System Inspection by: date

HEALTH DEPT COPY WHITE INSPECTION COPY (FINAL) GREEN OWNER COPY (FINAL) YELLOW INSPECTION COPY (INITIAL) PINK OWNER COPY (INITIAL) GOLD

i85500