IREDELL COUNTY HEALTH DEPARTMENT

STATESVILLE 704-878-5305 (ab) MOORESVILLE 704-664-5281

IMPROVEMENT PERMIT / AUTHORIZATION TO CONSTRUCT / OPERATION PERMIT / EXISTING SYSTEM INSPECTION

PERMIT # 15T948 20 PIN # 4705-48-3346 DATE 9/09/09

OWNER or APPLICANT Elizabeth & Sharon Faunce PHONE: Business Home: (704) 883-0116

OWNER or APPLICANT ADDRESS 128 Pinefield Drive Statesville NC 28625

LOCATION / DIRECTIONS Hwy 64 West TL Zippa Mountain Rd TR Happy Acres TL Railway Rd TL Faunce Drive down on Right at end of cul-de-sac

SUBDIVISION Casa Grande BLOCK / SECTION 3 LOT # 3 LOT AREA 2.21Ac DESIGN FLOW 360gpd L.T.A.R. 0.25gal/ft²/day

Septic Tank	1000	Gallons: STB	929/620	Date	8-28-09	☒ New System	☐ Repair	☐ Expansion System	Type I II III IV V VI	☒ Residence	No. Bedrooms 3
Pump Tank	1000	Gallons: P T	929	Date	10-4-09	System Description: Pump -25% Reduction				☐ Business	No. Persons
Pump Make	Zoeller	Model	WN1406	Serial #	535M1023	Repair System Description: Gravity -25% 50% Red'n				☐ Other	No. Employees
Nitrification Field	No Fields 1	No Lines 4	Linear Feet 360			Maintenance Agreement Required	☐ YES	☒ NO		☐ Slab	☒ Crawl Space
Trench Width	36"	Max. Trench Bottom Depth	30"	Gravel Depth	N/A	☐ GRAVITY	☒ PRESSURE			☐ Basement w/plumbing	☐ Basement w/o plumbing

Water Supply: ☐ Private ☒ Public ☐ Community

Comments / Conditions

Install drain lines as flagged; Trench bottom to be installed no deeper than 30" & Minimum pump size required 339 gpm, TDH (Elevation) & Maintain setbacks as shown

~~DO NOT DRIVE OVER TANKS~~

Comments / Conditions

INITIAL SITE SKETCH

Please see Sheets 1 & 2 Attached

AS BUILT SKETCH

Permit can be suspended or revoked if any false information is supplied toward securing the permit / any unauthorized changes are made to the site / any unauthorized changes are made in the installation of the system.

☒ *IMPROVEMENT PERMIT w / plat valid without expiration.* ☒ *IMPROVEMENT PERMIT w / site plan valid for 60 mos.* ☒ *AUTHORIZATION TO CONSTRUCT valid for period equal to IMPROVEMENT PERMIT-not to exceed 60 mo.*

Owner / Applicant Signature: Elizabeth Faunce Date 9/10/09

Improvement Permit by: Fred Clemmer / Steve Hellard Date 9/09/09

Authorization to Construct by: Fred Clemmer / STEVE Hellard Date 9/09/09

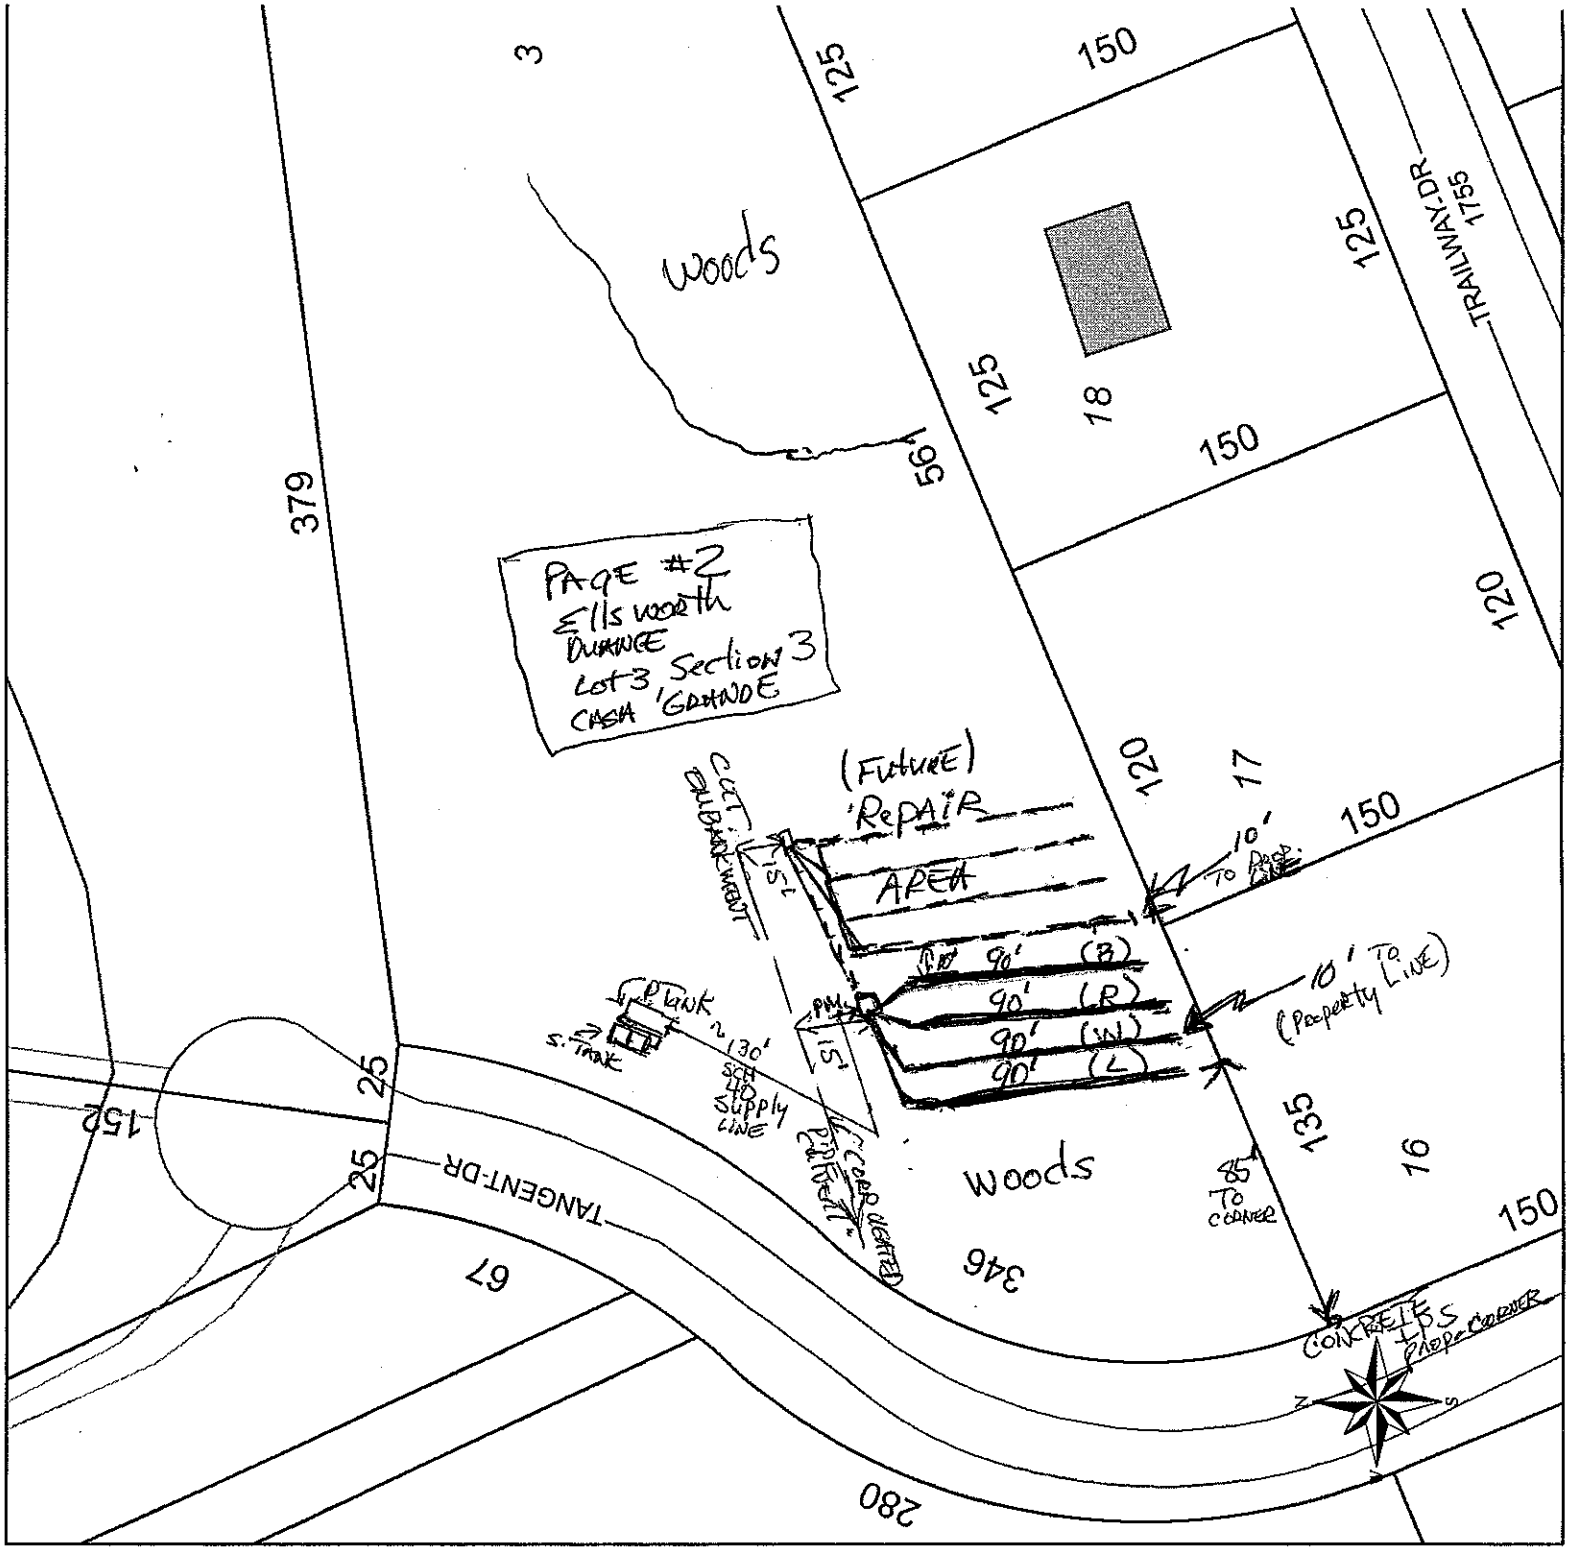
YOU SHOULD CONTACT A LOCATOR SERVICE PRIOR TO ANY EXCAVATION.

Installed by: Jimmy Reavis

Operation Permit by: [signature] Date: 1-6-10

Existing System Inspected by: Date:

WHITE COPY Environmental Health YELLOW COPY (Final) Owner / Applicant PINK COPY (Initial) Owner / Applicant


PAGE #2
Ellsworth
DURANGE
Lot 3, Section 3
CASA GRANDE
(Future)
REPAIR
AREA
Woods
Woods
TRAILWAY-DR
1755
TANGENT-DR
CONCRETE
PROP. CORNER
S. TANK
SCH 40 SUPPLY LINE
CLEAN OUT
CAR LIGHTED
PROPERTY
10' TO PROP. LINE
85' TO CORNER
379
595
280
67
346
135
120
125
150
25
152
18
17
16