IREDELL COUNTY HEALTH DEPARTMENT

STATESVILLE 704-878-5305 MOORESVILLE 704-664-5281

IMPROVEMENT PERMIT / AUTHORIZATION TO CONSTRUCT / OPERATION PERMIT / EXISTING SYSTEM INSPECTION

PERMIT# 72392 PIN# 4705 48 3873 DATE 4-8-98

OWNER OR CONTRACTOR Ernest Runge PHONE: Business 872 6645 Home

ADDRESS 374 Long Island Rd Statesville, N.C.

LOCATION 64 West to Lippard Fm Rd TR Happy Inn Turn Trailway Turn Tangent at end Rt

SUBDIVISION Cassa Grande BLOCK / SECTION IV LOT 2 LOT AREA 2.5 acres SITE CLASS PS DESIGN FLOW 360 L.T.A.R. .14

Septic Tank: 1000 Gallons; STB 796 Date 6-21-98
Pump Tank: Gallons; PT Date
Pump Make: Model Serial No.
Nitrification Field: No Fields 1 Square Feet 800 Linear Feet 150
No Lines 2 Trench Width 24" Max Trench Bottom Depth 36" Gravel Depth N/A

☒ New System ☐ Repair System Type: I, II, III IV, V, VI
System Description: Gravity Panels
Repair System Description: Pump to Panels
Maintenance Agreement Required: ☐ Yes ☐ No


☐ House/Mod. Home No. Bedrooms 3
☐ Mobile Home No. Bathrooms 2
☐ Business No. Employees
☐ Other
☐ Slab ☐ Crawl Space ☐ Basement w/plumbing ☐ Basement wo/plumbing

Water Supply: ☐ Individual ☒ Public ☐ Community


Comments:/Conditions:
Large amount of cutting + Filling voided Permit
Issued 3-23-98
403'

Comments:/Conditions:
Repair area

INITIAL SITE SKETCH

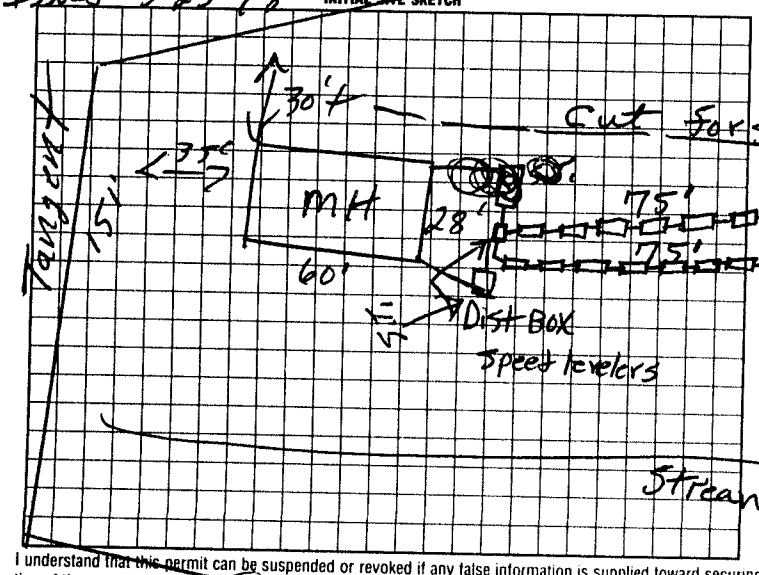

AS BUILT SKETCH

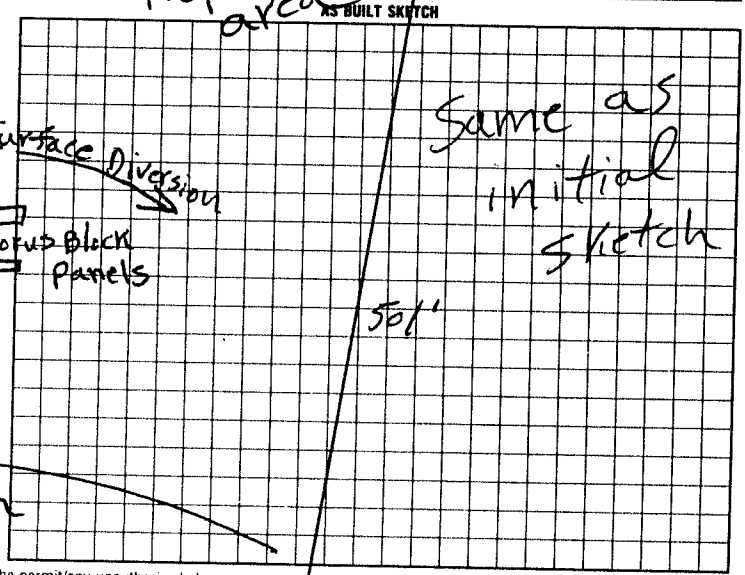

I understand that this permit can be suspended or revoked if any false information is supplied toward securing the permit/any unauthorized changes are made to the site/any unauthorized changes are made in the installation of the system. Improvement Permit with plat valid without expiration. Improvement Permit with site plan valid for sixty months. Authorization to Construct is valid for a period equal to that of Improvement Permit – not to exceed sixty months.

Signed: date

Improvement Permit by: R.C. moore date 4-8-98

Authorization to Construct by: R.C. moore date 4-8-98

Installed by: G&M Enterprizes

Operation Permit by: R.C. moore date 1-13-99

Existing System Inspection by: date

HEALTH DEPT. COPY: WHITE INSPECTION COPY (FINAL): GREEN OWNER COPY (FINAL): YELLOW INSPECTION COPY (INITIAL): PINK OWNER COPY (INITIAL): GOLD