pd 225 11-17-97

IREDELL COUNTY HEALTH DEPARTMENT

STATESVILLE 704-878-5305 MOORESVILLE 704-664-5281

IMPROVEMENT PERMIT / CERTIFICATE OF COMPLETION / OPERATION PERMIT / EXISTING SYSTEM INSPECTION

PROPERTY DESCRIPTION NO. 070179 DATE 11-15-97 TAX MAP NO. 4705 48 4262 Watershed: ☐ Yes ☒ No

OWNER OR CONTRACTOR ERNEST RUNGE PHONE: Business Home 872-6645

ADDRESS 374 LONG ISLAND ROAD, STATESVILLE, NC 28677

LOCATION US 64 W, TL LIPPARD FARM, TR HAPPY ACRES, TL TRAILWAY, BEAR (L), 3RD LOT ON (L) AST TANGENT DRIVE

SUBDIVISION CASA GRANDE BLOCK / SECTION II LOT 18 LOT AREA 13,712 ft² SITE CLASS. PS DESIGN FLOW 360 L.T.A.R. 0.30 GPD/FT²

Septic Tank: 1000 Gallons; STB 1012 Date 2-26-98

Pump Tank: _____ Gallons; PT _____ Date _____

Pump Make: _____ Model _____ Serial No. _____

Nitrification Field: No Fields 1 Square Feet EQ. TO 1200 Linear Feet ~ 300

No Lines FOUR Trench Width 36" Max Trench Bottom Depth 36" ~~Gravel~~ Depth SAND 6"

☒ New System ☐ Repair System Type: I, II, ☒ III, IV, V, VI

System Description: CHAMBERED GRAVITY

Repair System Description: PDBPS - LOW PRESSURE

Maintenance Agreement Required: ☐ Yes ☒ No

☐ House/Mod. Home ☒ Mobile Home ☐ Business ☐ Other

No. Bedrooms 3 No. Bathrooms 2 No. Employees _____


☐ Slab ☒ Crawl Space ☐ Basement w/plumbing ☐ Basement wo/plumbing

Water Supply: ☐ Individual ☐ Community ☒ Public

Comments: ① INSTALL FIFTY CHAMBERS IN FOUR LINES ON CONTOUR AS SHOWN ② KEEP SYSTEM MINIMUM 15' FROM TOP OF SLOPE OF EMBANKMENT

Comments:

INITIAL SITE SKETCH SCALE: 1" = 40'

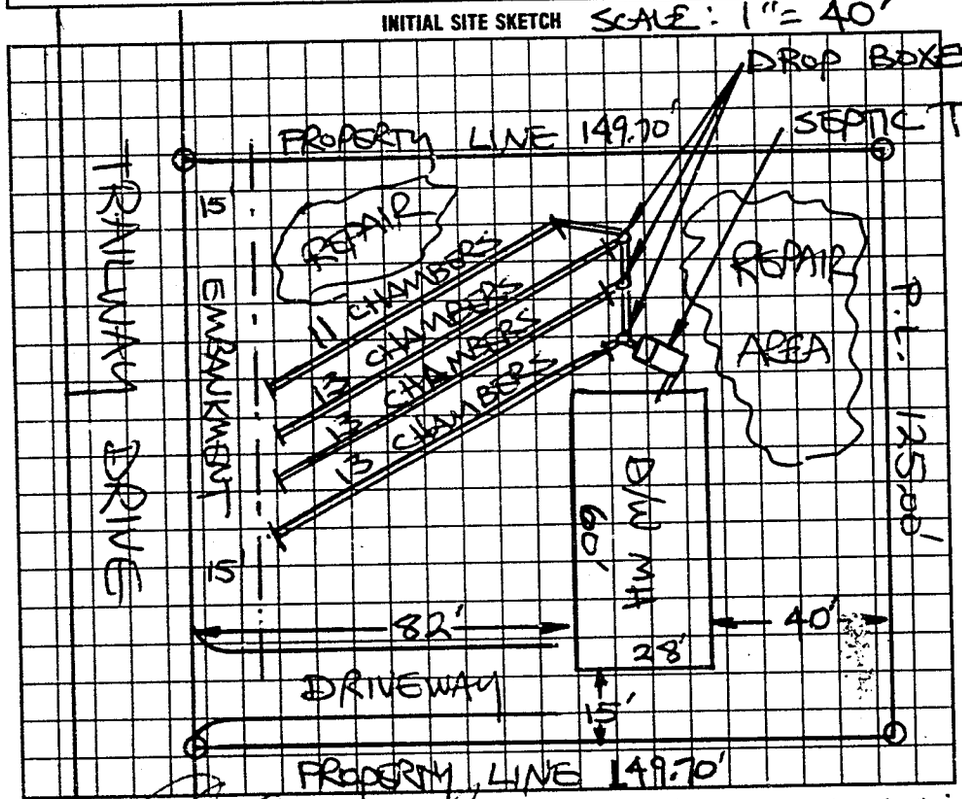

AS BUILT SKETCH

Installed as shown

I understand that this permit can be suspended or revoked if any false information is supplied toward securing the permit/any unauthorized changes are made to the site/any unauthorized changes are made in the installation of the system. Improvement Permit is valid for 60 months from date of issuance. AUTHORIZATION TO CONSTRUCT IS VALID FOR 60 MONTHS FROM DATE OF ISSUANCE.

Signed: _____ Installed by: A-1 Backhoe

Improvement Permit by: STEVE HEDRICK date 11-15-97

AUTH. TO CONST ~~Existing System Inspection~~ by: STEVE HEDRICK date 11-15-97

~~Certificate of Completion~~ by: _____ date _____

Operation Permit by: Marc Outlaw date 4-15-98

HEALTH DEPT. COPY: WHITE INSPECTION COPY (FINAL): GREEN OWNER COPY (FINAL): YELLOW INSPECTION COPY (INITIAL): PINK OWNER COPY (INITIAL): GOLD

0 6 3 3 0 0