IREDELL COUNTY HEALTH DEPARTMENT

STATESVILLE 704-878-5305 MOORESVILLE 704-664-5281

IMPROVEMENT PERMIT / CERTIFICATE OF COMPLETION / OPERATION PERMIT / EXISTING SYSTEM INSPECTION

PROPERTY DESCRIPTION NO. 26156 DATE 3-5-97 TAX MAP NO. 4705587674 Watershed: ☐ Yes ☒ No

OWNER OR CONTRACTOR Ernest Runge PHONE: Business 872-6645 Home

ADDRESS 374 Long Island Ln Statesville NC

LOCATION I-40 to 49 TL Lippard Farm TL Happy Acres TL Trailway Dr go 900' lot on Right

SUBDIVISION Casa Grande BLOCK / SECTION LOT 19 LOT AREA 125 x 149 SITE CLASS. V/S DESIGN FLOW 360 L.T.A.R. .032

Septic Tank: 1000 Gallons; STB 786 Date 3-8-97

Pump Tank: Gallons; PT Date

Pump Make: Model 340 Serial No.

Nitrification Field: No Fields 1 Square Feet ~~315~~ Linear Feet 280

No Lines 5 Trench Width 36in Max Trench Bottom Depth 36in ~~Gravel Depth~~ Sand

☒ New System ☐ Repair System Type: I, II, III, IV, V, VI

System Description: Gravelless Chambers

Repair System Description: Partial Repair

Maintenance Agreement Required: ☐ Yes ☒ No

☐ House/Mod. Home ☒ Mobile Home ☐ Business ☐ Other

No. Bedrooms 3 No. Bathrooms 2 No. Employees


☐ Slab ☒ Crawl Space ☐ Basement w/plumbing ☐ Basement wo/plumbing

Water Supply: ☐ Individual ☐ Community ☒ Public


Comments: Keep lines on contour 9ft on center

Comments:

INITIAL SITE SKETCH

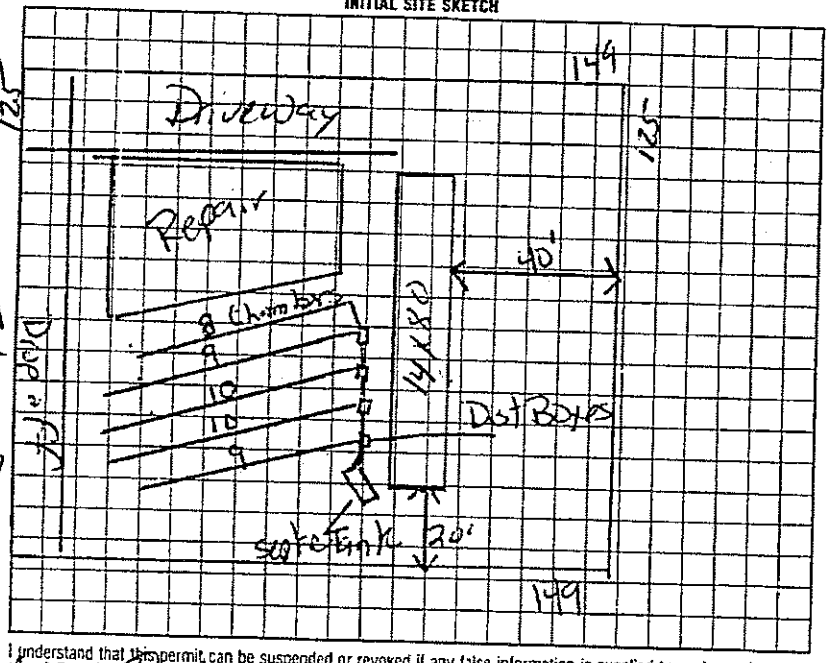

AS BUILT SKETCH

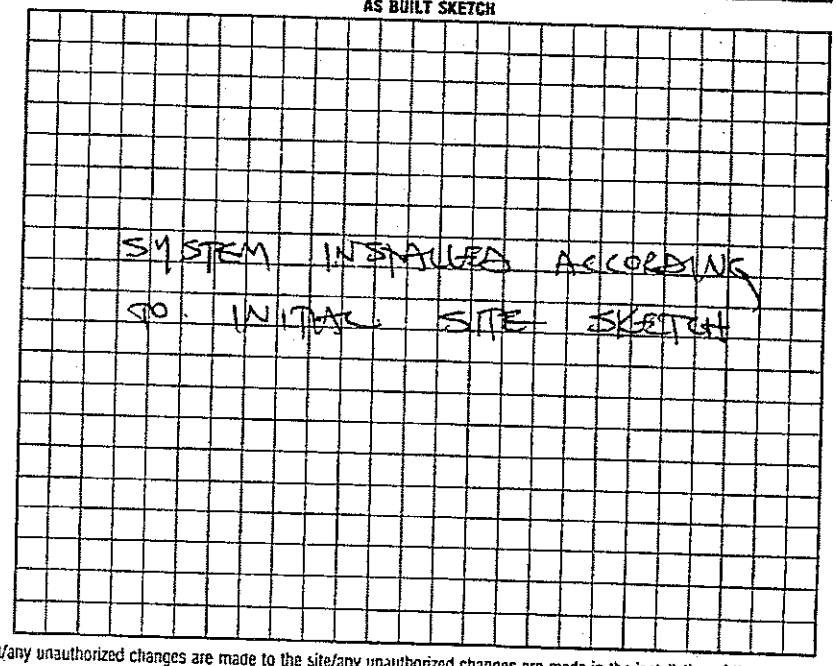

I understand that this permit can be suspended or revoked if any false information is supplied toward securing the permit/any unauthorized changes are made to the site/any unauthorized changes are made in the installation of the system.

Signed: Author. extra bedroom request expires 5yrs from issue date

Improvement Permit by: Mark C. Offs date 3-5-97

Existing System Inspection by: Author. extra bedroom request. Mark C. Offs date 3-5-97

Installed by: G & M ENTERPRISES

Certificate of Completion by: date

Operation Permit by: STEVE HEDRICK date 5-7-97

HEALTH DEPT. COPY: WHITE INSPECTION COPY (FINAL): GREEN OWNER COPY (FINAL): YELLOW INSPECTION COPY (INITIAL): PINK OWNER COPY (INITIAL): GOLD