IREDELL COUNTY HEALTH DEPARTMENT

Statesville Office (704) 878-5305 Mooresville Office (704) 660-3625 PERMIT # 179806

IMPROVEMENT PERMIT / AUTHORIZATION TO CONSTRUCT / OPERATION PERMIT / EXISTING SYSTEM

PIN # 4705485256

APPLICANT: Vicky Johnston APPLICANT ADDRESS: 255 Streamside Pl

SITE ADDRESS: 174 Trailway Dr. PHONE: 704-223-5492 ALT. PHONE: N/A

SITE DIRECTIONS: Hwy 64/90W TL Lippard Farm Rd. TR Happy Acres TL Trailway Dr.

SUBDIVISION: Casa Grande SECTION: 1 LOT # 19 LOT AREA: 0.42 acres DESIGN FLOW: 360gpd L.T.A.R.: Existing

Septic Tank: Existing (gal) STB: Date:
Pump Tank: (gal) PT: Date:
Pump Make: Model: Serial #:
Nitrification Fields: 1 # Lines: 5 Linear Ft: Ex
Trench Width: Ex Max. Trench Bottom Depth: Ex Gravel Depth: Ex

☐ New System ☐ Repair ☐ Expansion System Type: I II ☑ III IV V VI
System Description: 25% Reduction
Repair System Description:
Maintenance Agreement Required: ☐ YES ☑ NO
☐ GRAVITY ☐ PRESSURE

☑ Residence No. Bedrooms: 3
☐ Business No. Persons:
☐ Other No. Employees:
☐ Slab ☑ Crawl Space
☐ Basement w/plumbing ☐ Basement w/o plumbing


Water Supply: ☐ Private ☑ Public ☐ Community

Comments / Conditions:

- Maintain a minimum of 5' between home foundation and all components of septic tank system.

INITIAL SITE SKETCH

AS BUILT SKETCH

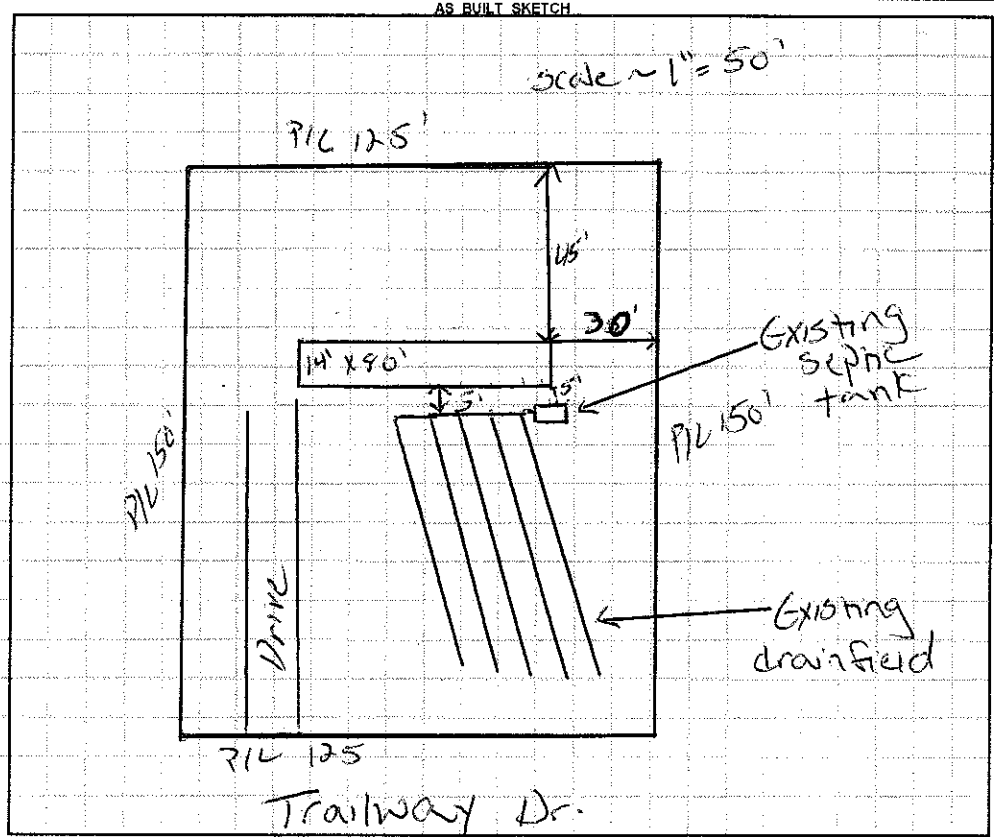

Permit can be suspended or revoked if any false information is supplied toward securing the permit / any unauthorized changes are made to the site / any unauthorized changes are made in the installation of the system. **CONTACT A LOCATOR SERVICE PRIOR TO ANY EXCAVATION**

☐ **IMPROVEMENT PERMIT** *with plat valid without expiration.* ☐ **IMPROVEMENT PERMIT** *with site plan valid for 60 mos.* ☐ **AUTHORIZATION TO CONSTRUCT** *valid for period equal to IMPROVEMENT PERMIT--not to exceed 60 mo.*

Owner / Applicant Signature: Vicky Johnston Date: 7-30-13 Installed by:

IMPROVEMENT PERMIT by: Date: OPERATION PERMIT by: Date:

AUTHORIZATION TO CONSTRUCT by: Date: Existing System Inspected by: Justin Henderson Date: 7-29-13

Health Dept. Copy - WHITE Applicant (Final Approval) - YELLOW Applicant (Conditional Approval) - PINK