IREDELL COUNTY HEALTH DEPARTMENT

STATESVILLE 704-878-5305 MOORESVILLE 704-664-5281

IMPROVEMENT PERMIT / CERTIFICATE OF COMPLETION / OPERATION PERMIT / EXISTING SYSTEM INSPECTION

PROPERTY DESCRIPTION NO. 26159 DATE 3-14-97 TAX MAP NO. 4705587674

OWNER OR CONTRACTOR Ernest Runge PHONE: Business 8726646 Home

ADDRESS 374 Long Island Rd Statesville Watershed: ☐ Yes ☒ No

LOCATION 64 E on TI Liggard Farm Rd TR Happy Acres TL Trailway Bend Rt 1st on left 400 ft

SUBDIVISION Casa Grande BLOCK / SECTION + LOT 23 LOT AREA 22,124 SITE CLASS P/S DESIGN FLOW 360 L.T.A.R. 0.3

Septic Tank: 1000 Gallons; STB 620 Date 2-21-97

Pump Tank: Gallons; PT Date

Pump Make: Model Serial No.

Nitrification Field: No Fields 1 Square Feet 1200 Linear Feet 400

No Lines 4 Trench Width 36in Max Trench Bottom Depth 36in

☒ New System ☐ Repair System Type: I, II, III, IV, V, VI

System Description: Gravity Conventional

Repair System Description: " " Cranberry

Maintenance Agreement Required: ☐ Yes ☐ No Pumps

Gravel Depth 12in ☐ Slab ☒ Crawl Space ☐ Basement w/plumbing ☐ Basement wo/plumbing

☐ House/Mod. Home ☒ Mobile Home ☐ Business ☐ Other


No. Bedrooms 3 No. Bathrooms 2 No. Employees

Water Supply: ☐ Individual ☐ Community ☒ Public


Comments: Keep lines on contour 9 Ft on center

Comments:

INITIAL SITE SKETCH

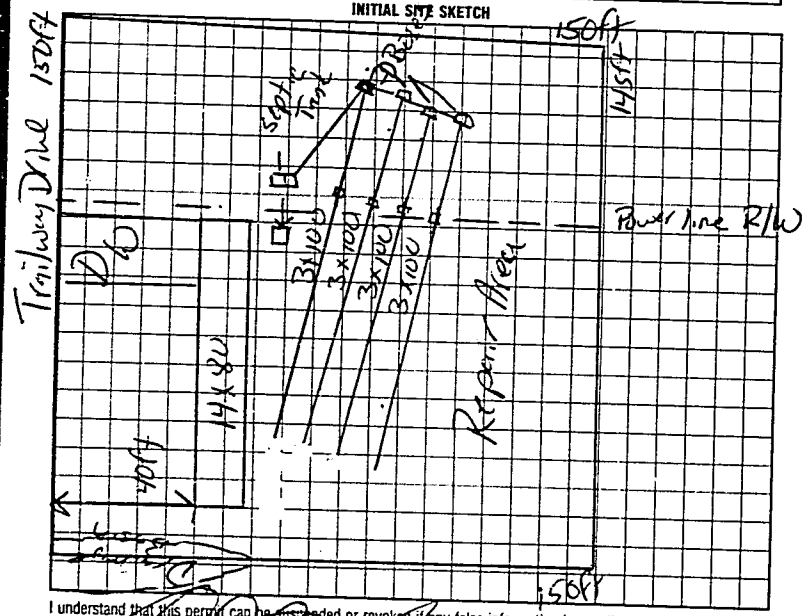

AS BUILT SKETCH

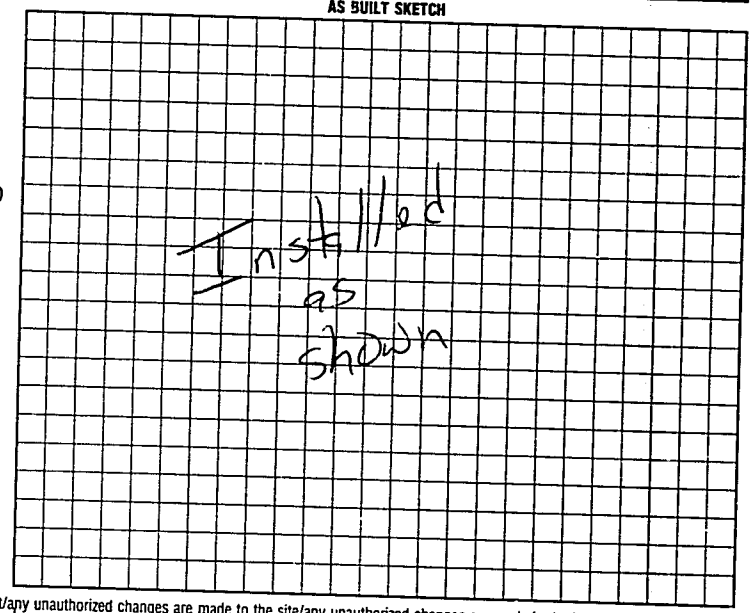

I understand that this permit can be suspended or revoked if any false information is supplied toward securing the permit/any unauthorized changes are made to the site/any unauthorized changes are made in the installation of the system. Improvement Permit is valid for 60 months from date of issuance. Authorization to construct expires 5yr from issue date

Signed:

Improvement Permit by: Mary C Ong RS date 3-14-97

Existing System Inspection by: Mary C Ong RS date 3-14-97

Installed by: Sammy & Peggy

Certificate of Completion by: date

Operation Permit by: Mary C Ong RS date 4-8-97

HEALTH DEPT COPY WHITE INSPECTION COPY (FINAL) GREEN OWNER COPY (FINAL) YELLOW INSPECTION COPY (INITIAL) PINK OWNER COPY (INITIAL) GOLD