IREDELL COUNTY HEALTH DEPARTMENT

THIS PERMIT VOIDS PREVIOUS ISSUED 6-7-97

STATESVILLE 704-878-5305 MOORESVILLE 704-664-5281

IMPROVEMENT PERMIT / AUTHORIZATION TO CONSTRUCT / OPERATION PERMIT / EXISTING SYSTEM INSPECTION

PERMIT# 067054 PIN# 4705 476919 (PART OF) DATE 4-25-98

OWNER OR CONTRACTOR ERNEST RUNGE PHONE: Business Home 872-6645

ADDRESS 374 LONG ISLAND ROAD, STATESVILLE, NC 28677

LOCATION US 64 W, TL LIPPARD FARM, TR HAPPY ACRES, TL TRAILWAY DRIVE, BEAR LEFT, 6TH LOT ON RIGHT

SUBDIVISION CASA GRANDE BLOCK / SECTION II LOT 36 LOT AREA 21,375 SF SITE CLASS. PS DESIGN FLOW 360 L.T.A.R. 0.30 SQ FT/GPD

Septic Tank: 1000 Gallons; STB 1012 Date 3-2-98

Pump Tank: _____ Gallons; PT _____ Date _____

Pump Make: _____ Model _____ Serial No. _____

Nitrification Field: No Fields 1 Square Feet ~~EQ TO~~ 1200 Linear Feet 300+

No Lines FOUR Trench Width 36" Max Trench Bottom Depth 30-42" Gravel Depth SAND 6"

☑ New System ☐ Repair System Type: I, II, III, IV, V, VI

System Description: CHAMBERED GRAVITY

Repair System Description: PPBPS - PUMP

Maintenance Agreement Required: ☐ Yes ☑ No

☐ House/Mod. Home ☑ Mobile Home ☐ Business ☐ Other

No. Bedrooms 3 No. Bathrooms 2 No. Employees ____


☐ Slab ☑ Crawl Space ☐ Basement w/plumbing ☐ Basement wo/plumbing

Water Supply: ☐ Individual ☑ Public ☐ Community

Comments:/Conditions ① SET TANK TOP AT GROUND LEVEL & BACK-FILL MOUND OVER IT ② INSTALL 50 CHAMBERS IN FOUR LINES AS FLAGGED, NO DEEPER THAN 42"

Comments:/Conditions:

INITIAL SITE SKETCH SCALE: 1" = 40'

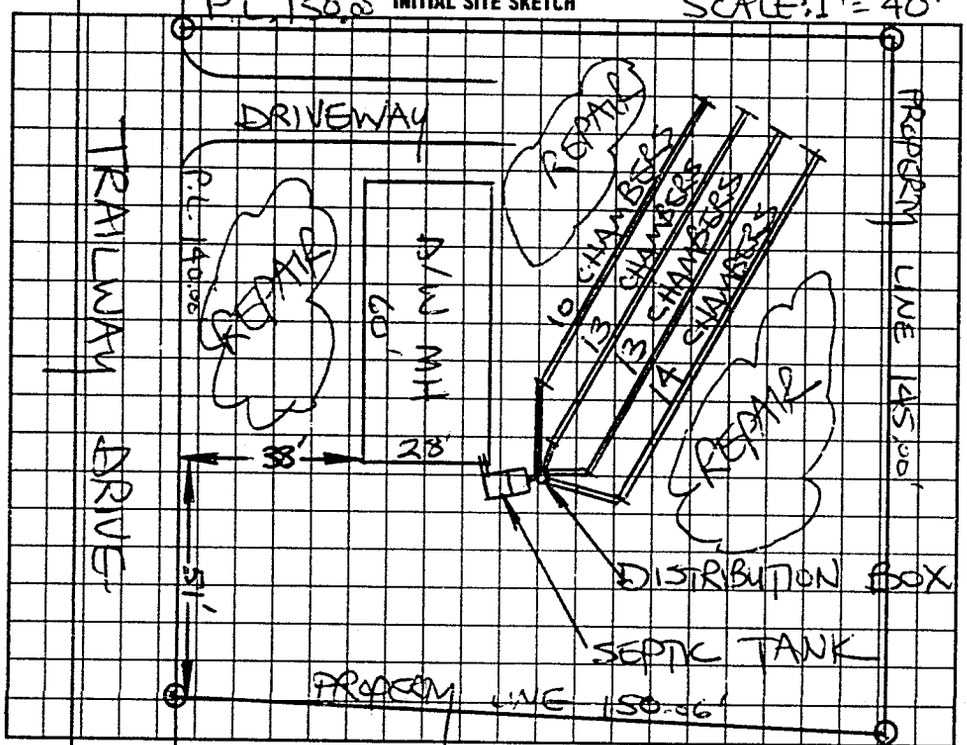

AS BUILT SKETCH

Installed as shown

I understand that this permit can be suspended or revoked if any false information is supplied toward securing the permit/any unauthorized changes are made to the site/any unauthorized changes are made in the installation of the system. Improvement Permit with plat valid without expiration. Improvement Permit with site plan valid for sixty months. Authorization to Construct is valid for a period equal to that of Improvement Permit – not to exceed sixty months.

Signed: _____ date 4-25-98

Improvement Permit by: STEVE HEDRICK date 4-25-98

Authorization to Construct by: STEVE HEDRICK date 4-25-98

Installed by: A-1 Backhoe

Operation Permit by: Mark Collins date 5-6-98

Existing System Inspection by: _____ date _____

HEALTH DEPT. COPY: WHITE INSPECTION COPY (FINAL): GREEN OWNER COPY (FINAL): YELLOW INSPECTION COPY (INITIAL): PINK OWNER COPY (INITIAL): GOLD