IREDELL COUNTY HEALTH DEPARTMENT

STATESVILLE 704-878-5305 MOORESVILLE 704-664-5281

IMPROVEMENT PERMIT / CERTIFICATE OF COMPLETION / OPERATION PERMIT / EXISTING SYSTEM INSPECTION

PROJECT DESCRIPTION NO. 26158 DATE 3-5-97 TAX MAP NO. 4705587674 Watershed: ☐ Yes ☒ No

OWNER/CONTRACTOR Ernest Runge PHONE: Business 872-6645 Home

ADDRESS 374 Long Island Rd Statesville

LOCATION 64W TL Oppard Farm TR Happy Acres TL Trailway Dr sign to # on Left 900 ft

SUBDIVISION Casa Grande BLOCK / SECTION LOT 22 LOT AREA 21,377 SITE CLASS. D/S0 DESIGN FLOW 360 L.T.A.R. 0.3

Septic Tank: 1000 Gallons; STB 821 Date 3-16-97

Pump Tank: Gallons; PT Date

Pump Make: Model Serial No.

Nitrification Field: No Fields 1 Square Feet 1200 Linear Feet 400

No Lines 5 Trench Width 36in Max Trench Bottom Depth 36in Gravel Depth 12in

☒ New System ☐ Repair System Type: I, II, III, IV, V, VI

System Description: Gravity Conventional

Repair System Description: " "

Maintenance Agreement Required: ☐ Yes ☒ No

☐ Slab ☒ Crawl Space ☐ Basement w/plumbing ☐ Basement wo/plumbing

☐ House/Mod. Home ☒ Mobile Home ☐ Business ☐ Other


No. Bedrooms 3 No. Bathrooms 2 No. Employees

Water Supply: ☐ Individual ☐ Community ☒ Public


Comments: Keep lines on contour 9ft on Center

Comments:

INITIAL SITE SKETCH

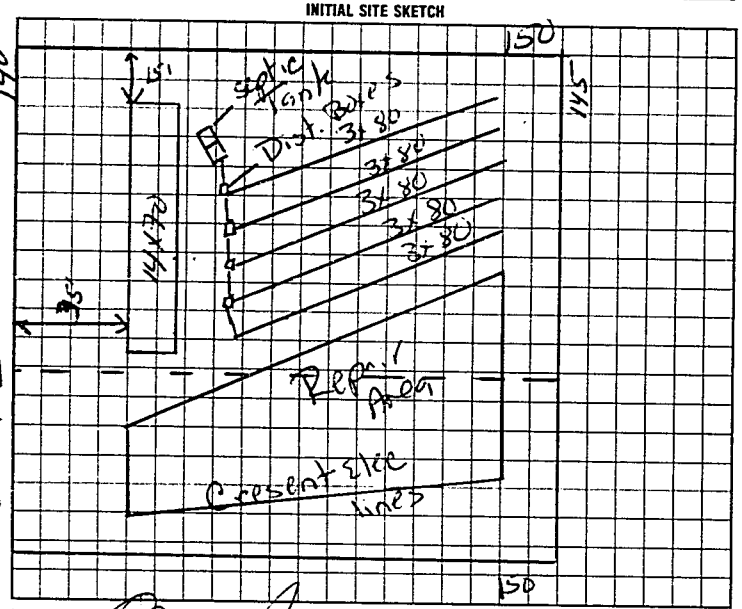

AS BUILT SKETCH

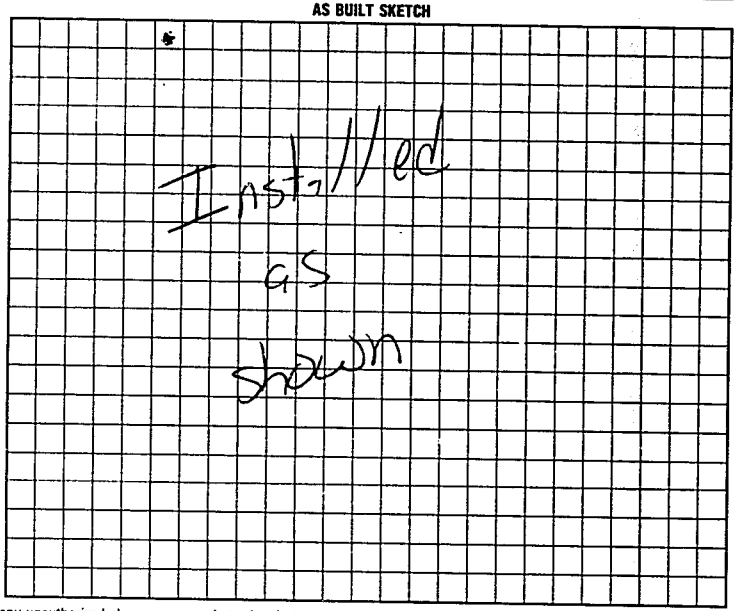

I understand that this permit can be suspended or revoked if any false information is supplied toward securing the permit/any unauthorized changes are made to the site/any unauthorized changes are made in the installation of the system. Improvement Permit is valid for 60 months from date of issuance. Authorization to const. expires 5yrs from issue date

Signed:

Improvement Permit by: Mark Coffis date 3-5-97

Existing System Inspection by: Mark Coffis date 3-5-97

Installed by: GSM Ent.

Certificate of Completion by: date

Operation Permit by: Mark Coffis date 4-17-97

HEALTH DEPT COPY WHITE | INSPECTION COPY (FINAL) GREEN | OWNER COPY (FINAL) YELLOW | INSPECTION COPY (INITIAL) PINK | OWNER COPY (INITIAL) GOLD

Authorization to const

672000