IREDELL COUNTY HEALTH DEPARTMENT

STATESVILLE 704-878-5305 MOORESVILLE 704-664-5281

IMPROVEMENT PERMIT / CERTIFICATE OF COMPLETION / OPERATION PERMIT / EXISTING SYSTEM INSPECTION

PROPERTY DESCRIPTION NO. 066537 DATE 5-31-97 TAX MAP NO. 4705476919 Watershed: ☐ Yes ☑ No

OWNER OR CONTRACTOR ERNEST RUNGE PHONE: Business Home 872-6645

ADDRESS 379 LONG ISLAND ROAD STATESVILLE, NC 28677

LOCATION US 64 W, TL LIPPARD FARM RD, TR HAPPY ACRES, TL TRAILWAY DR, 5TH LOT ON LEFT

SUBDIVISION CASA GRANDE BLOCK / SECTION II LOT 4 LOT AREA 25539 FT² SITE CLASS. PS DESIGN FLOW 240 L.T.A.R. 0.30 GPD/FT²

Septic Tank: 1000 Gallons; STB 1013 Date 4-14-97

Pump Tank: _____ Gallons; PT _____ Date _____

Pump Make: _____ Model _____ Serial No. _____

Nitrification Field: No Fields 1 Square Feet 810 Linear Feet 270

No Lines FOUR Trench Width 36" Max Trench Bottom Depth 36" Gravel Depth 12"

☑ New System ☐ Repair System Type: I (II) III, IV, V, VI

System Description: CONVENTIONAL GRAVITY

Repair System Description: CHAMBERED GRAVITY

Maintenance Agreement Required: ☐ Yes ☑ No

☐ House/Mod. Home No. Bedrooms 3

☑ Mobile Home No. Bathrooms 2

☐ Business No. Employees ____

☐ Other ____


☐ Slab ☑ Crawl Space ☐ Basement w/plumbing ☐ Basement wo/plumbing

Water Supply: ☐ Individual ☐ Community ☑ Public

Comments:

Comments:

INITIAL SITE SKETCH SCALE: 1" = 50'

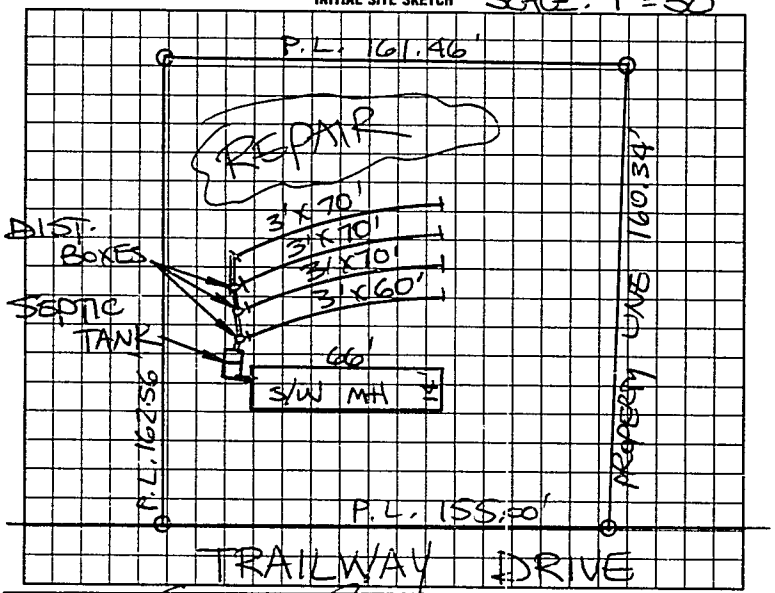

AS BUILT SKETCH

Inst. Hd as shown

I understand that this permit can be suspended or revoked if any false information is supplied toward securing the permit/any unauthorized changes are made to the site/any unauthorized changes are made in the installation of the system. Improvement Permit is valid for 60 months from date of issuance. AUTHORIZATION TO CONSTRUCT IS VALID FOR 60 MONTHS FROM DATE OF ISSUANCE. A-1

Signed: _____ Installed by: _____

Improvement Permit by: STEVE HEDRICK date 5-31-97 Certificate of Completion by: _____ date _____

AUTH. TO CONST. Existing System Inspection by: STEVE HEDRICK date 5-31-97 Operation Permit by: Mark Cuff RS date 6-9-97

HEALTH DEPT. COPY WHITE INSPECTION COPY (FINAL) GREEN OWNER COPY (FINAL) YELLOW INSPECTION COPY (INITIAL) PINK OWNER COPY (INITIAL) GOLD