pd 9/25 10-10-97

# IREDELL COUNTY HEALTH DEPARTMENT

STATESVILLE 704-878-5305 MOORESVILLE 704-664-5281

## IMPROVEMENT PERMIT / CERTIFICATE OF COMPLETION / OPERATION PERMIT / EXISTING SYSTEM INSPECTION

Watershed: ☐ Yes ☑ No

PROPERTY DESCRIPTION NO. 066536 DATE 10-4-97 TAX MAP NO. 4705476919 PHONE: Business Home 872-6645

OWNER OR CONTRACTOR ERNEST RUNGE

ADDRESS 374 LONG ISLAND ROAD, STATESVILLE, NC 28677

LOCATION US 64 W, TL LIPPARD FARM, TR HAPPY ACRES, TL TRAILWAY BEAR LEFT 4TH LOT ON LEFT

SUBDIVISION CASA GRANDE BLOCK / SECTION II LOT 3 LOT AREA 25,630 FT² SITE CLASS PS DESIGN FLOW 240 L.T.A.R. 0.2 GPD/FT²

Septic Tank: 1000 Gallons; STB 928 Date 7-16-98

Pump Tank: Gallons; PT Date

Pump Make: Model Serial No.

Nitrification Field: No Fields 1 Square Feet EQ. TO 1200 Linear Feet 200

No Lines FIVE Trench Width 24" Max Trench Bottom Depth 36" GRAVEL Depth 6"

☑ New System ☐ Repair System Type: I, II, III, IV, V, VI

System Description: PPBPS GRAVITY

Repair System Description: PPBRS - LPP

Maintenance Agreement Required: ☐ Yes ☑ No

☐ House/Mod. Home ☑ Mobile Home ☐ Business ☐ Other

No. Bedrooms 2 No. Bathrooms 2 No. Employees


☐ Slab ☑ Crawl Space ☐ Basement w/plumbing ☐ Basement wo/plumbing

Water Supply: ☐ Individual ☐ Community ☑ Public

Comments: ① INSTALL 45 PPBPS PANELS IN FIVE EQUAL LENGTH LINES ON CONTOUR AS SHOWN. ② SYSTEM SIZED FOR TWO BEDROOM ONLY.

Comments:

INITIAL SITE SKETCH SCALE: 1" = 50'

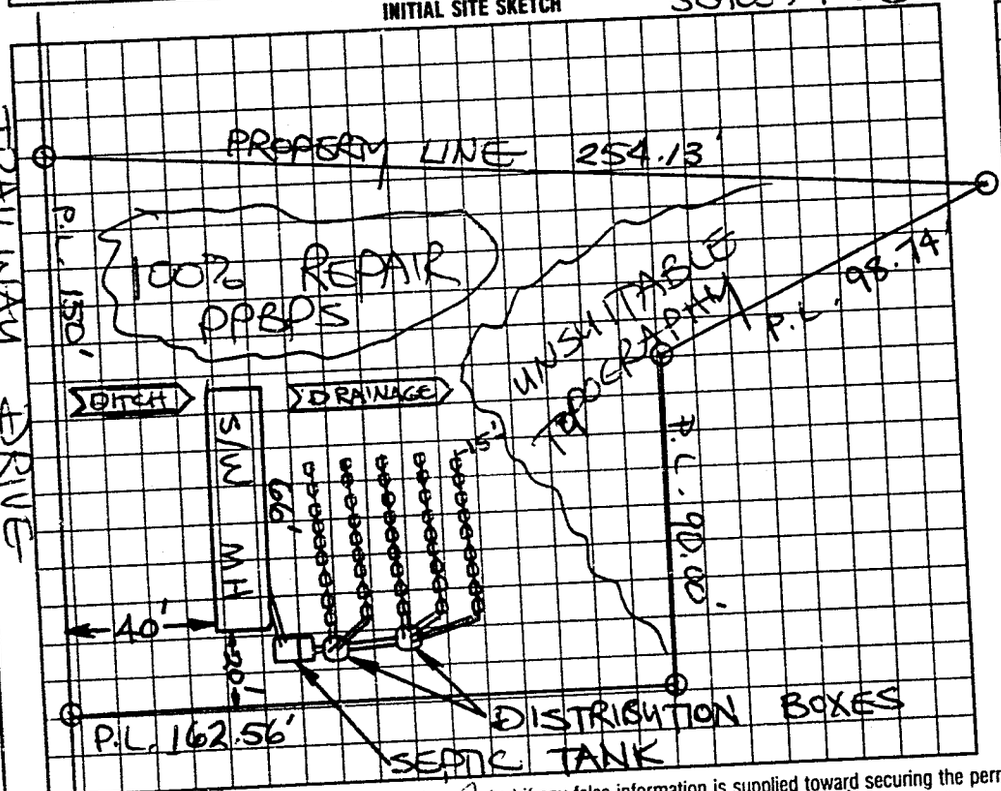


AS BUILT SKETCH

Same as initial sketch

I understand that this permit can be suspended or revoked if any false information is supplied toward securing the permit/any unauthorized changes are made to the site/any unauthorized changes are made in the installation of the system. Improvement Permit is valid for 60 months from date of issuance. AUTHORIZATION TO CONSTRUCT IS VALID FOR 60 MONTHS FROM DATE OF ISSUANCE.

Signed:

Improvement Permit by: STEVE HEDRICK date 10-4-97

AUTH. TO CONST.

~~Existing System Inspection~~ by: STEVE HEDRICK date 10-4-97

Installed by: Sammy Reavis date

~~Certificate of Completion by:~~

Operation Permit by: L. C. Moore date 9-24-98

HEALTH DEPT COPY: WHITE INSPECTION COPY (FINAL): GREEN OWNER COPY (FINAL): YELLOW INSPECTION COPY (INITIAL): PINK OWNER COPY (INITIAL): GOLD

98 E 00