pd 125 11-10-97

IREDELL COUNTY HEALTH DEPARTMENT

STATESVILLE 704-878-5305 MOORESVILLE 704-664-5281

IMPROVEMENT PERMIT / CERTIFICATE OF COMPLETION / OPERATION PERMIT / EXISTING SYSTEM INSPECTION

PROPERTY DESCRIPTION NO. 070176 DATE 11-8-97 TAX MAP NO. 4705 57 4909 Watershed: ☐ Yes ☑ No

OWNER OR CONTRACTOR ERNEST RUNGE PHONE: Business Home 872-6645

ADDRESS 374 LONG ISLAND RD, STATESVILLE, NC 28677

LOCATION US 64 W, TL LIPPARD FARM, TR HAPPY ACRES, TL TRAILWAY, BEAR (L) 2ND LOT ON LEFT

SUBDIVISION CASA GRANDE BLOCK / SECTION II LOT 2 LOT AREA 34,358 FT² SITE CLASS. PS DESIGN FLOW 360 L.T.A.R. 0.25 GPD/FT²

Septic Tank: 1000 Gallons; STB 821 Date 10-27-97 ☑ New System ☐ Repair System Type: I, II, III, IV, V, VI

Pump Tank: Gallons; PT Date System Description: CHAMBERED GRAVITY

Pump Make: Model Serial No. Repair System Description: CHAMBERED GRAVITY

Nitrification Field: No Fields 1 Square Feet 1440 Linear Feet 360 Maintenance Agreement Required: ☐ Yes ☑ No Panels

No Lines FOUR Trench Width 36" Max Trench Bottom Depth 36" Gravel Depth STND 6" ☐ Slab ☑ Crawl Space ☐ Basement w/plumbing ☐ Basement wo/plumbing

☐ House/Mod. Home No. Bedrooms 3

☑ Mobile Home No. Bathrooms 2

☐ Business No. Employees


☐ Other

Water Supply: ☐ Individual ☐ Community ☑ Public


Comments: (1) INSTALL SIXTY CHAMBERS IN FOUR EQUAL LENGTH LINES ON CONTOUR (2) SCOUR TRENCH SIDEWALLS WHERE SMEARING OCCURS.

Comments:

SCALE: 1"=40' INITIAL SITE SKETCH

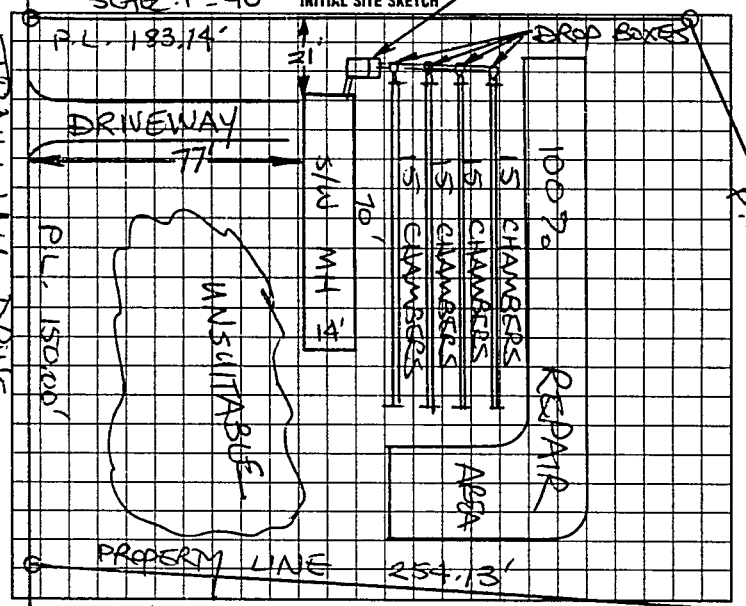

AS BUILT SKETCH

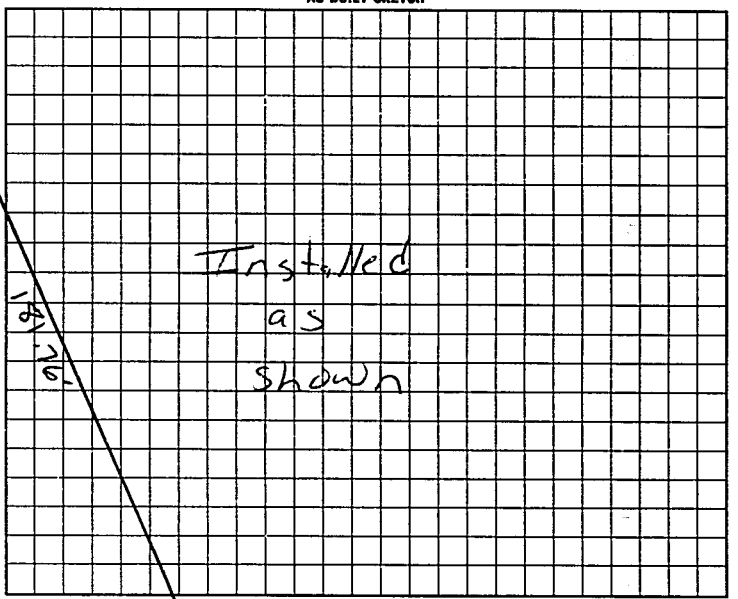

I understand that this permit can be suspended or revoked if any false information is supplied toward securing the permit/any unauthorized changes are made to the site/any unauthorized changes are made in the installation of the system. Improvement Permit is valid for 60 months from date of issuance. AUTHORIZATION TO CONSTRUCT IS VALID FOR 60 MONTHS FROM DATE OF ISSUANCE.

Signed:

Improvement Permit by: STEVE HEDRICK date 11-8-97

AUTH. TO CONST. ~~Existing System Inspection~~ by: STEVE HEDRICK date 11-8-97

Installed by: G & M Enterprises

~~Certificate of Completion~~ by: date

Operation Permit by: Mark C. Onks date 12-17-97

HEALTH DEPT. COPY. WHITE INSPECTION COPY (FINAL). GREEN OWNER COPY (FINAL). YELLOW INSPECTION COPY (INITIAL). PINK OWNER COPY (INITIAL). GOLD

00243