IREDELL COUNTY HEALTH DEPARTMENT

THIS PERMIT VOIDS PREVIOUS ISSUED 10-18-97

STATESVILLE 704-878-5305 MOORESVILLE 704-664-5281

IMPROVEMENT PERMIT / AUTHORIZATION TO CONSTRUCT / OPERATION PERMIT / EXISTING SYSTEM INSPECTION

PERMIT# 067056 PIN# 4705 47 6919 (PT) DATE 1-14-98

OWNER OR CONTRACTOR ERNEST RUNGE PHONE: Business Home 872-6645

ADDRESS 374 LONG ISLAND RD STATESVILLE, NC 28677

LOCATION US 64 W, TL LIPPARD FARM, TR HAPPY ACRES, TL TRAILWAY, BEAR LEFT, 3RD LOT ON RIGHT

SUBDIVISION CASA GRANDE BLOCK / SECTION II LOT 38 LOT AREA 16,654 FT² SITE CLASS PS DESIGN FLOW 360 L.T.A.R. 0.30 SQ FT

Septic Tank: 1000 Gallons; STB 1012 Date 12-10-98

Pump Tank: ____ Gallons; PT ____ Date ____

Pump Make: ____ Model ____ Serial No. ____

Nitrification Field: No Fields 1 Square Feet 60 TO 1200 Linear Feet 300+

No Lines FIVE Trench Width 36" Max Trench Bottom Depth 36" Gravel Depth 3 AND 6"

☒ New System ☐ Repair System Type: I, II, III, IV, V, VI

System Description: CHAMBERED GRAVITY

Repair System Description: PPBPS PUMP

Maintenance Agreement Required: ☐ Yes ☒ No

☐ House/Mod. Home ☑ Mobile Home ☐ Business ☐ Other

No. Bedrooms 3 No. Bathrooms 2 No. Employees ____


☐ Slab ☑ Crawl Space ☐ Basement w/plumbing ☐ Basement wo/plumbing

Water Supply: ☐ Individual ☑ Public ☐ Community


Comments:/Conditions: ① KEEP SYSTEM MINIMUM 10' FROM WATER LINE ② INSTALL FIFTY (50) 6' CHAMBERS IN FIVE EQUAL LENGTH LINES AS PLACED ON SITE.

Comments:/Conditions:

INITIAL SITE SKETCH SCALE 1"=30'

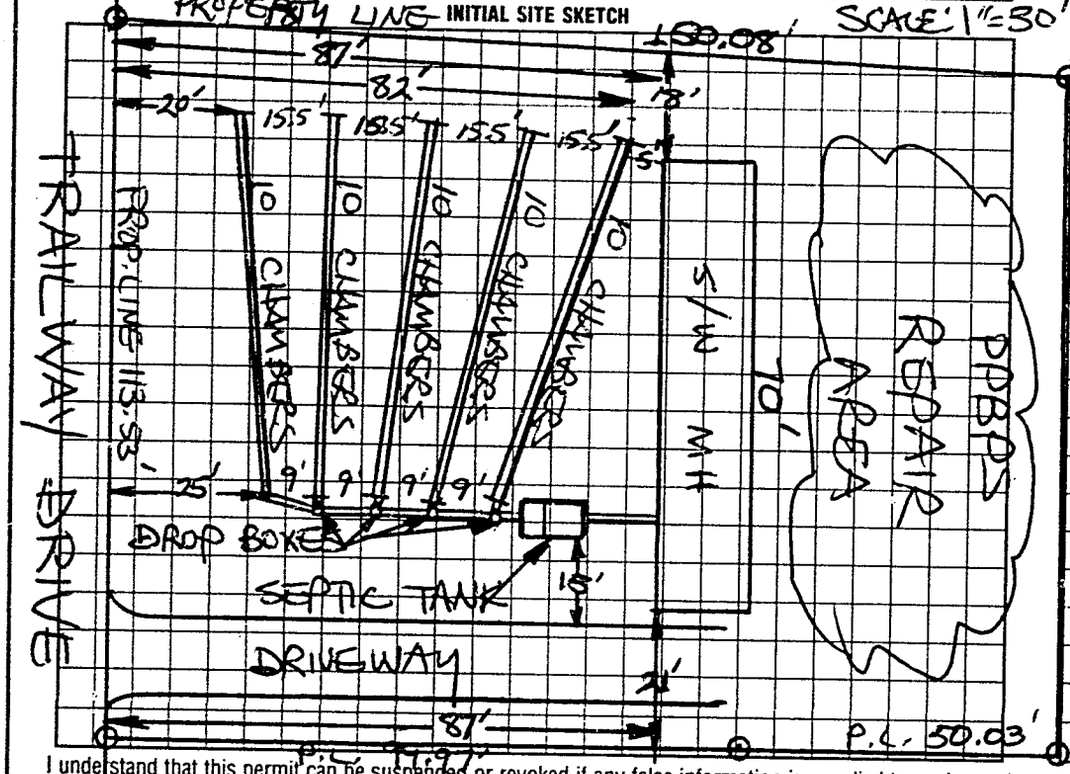

AS BUILT SKETCH

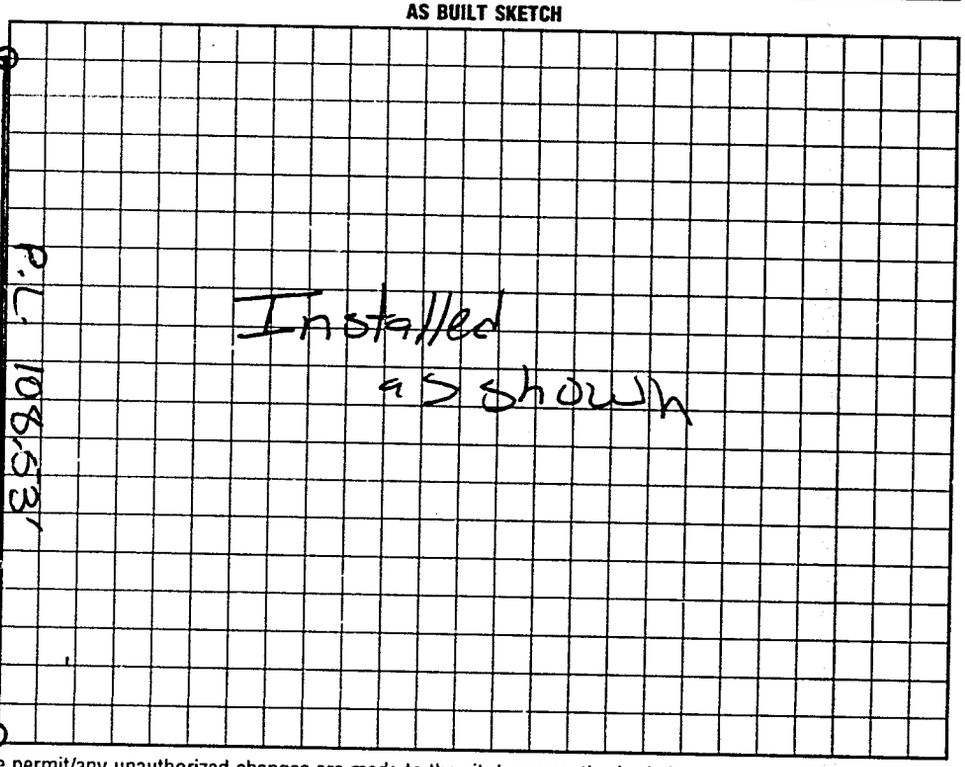

I understand that this permit can be suspended or revoked if any false information is supplied toward securing the permit/any unauthorized changes are made to the site/any unauthorized changes are made in the installation of the system. Improvement Permit with plat valid without expiration. Improvement Permit with site plan valid for sixty months. Authorization to Construct is valid for a period equal to that of Improvement Permit – not to exceed sixty months.

Signed: ____ date ____

Improvement Permit by: STEVE HEDRICK date 1-14-98

Authorization to Construct by: STEVE HEDRICK date 1-14-98

Installed by: Kenny Madison

Operation Permit by: M & C Onsite Ltd date 3-17-98

Existing System Inspection by: ____ date ____

HEALTH DEPT COPY: WHITE INSPECTION COPY (FINAL) GREEN OWNER COPY (FINAL) YELLOW INSPECTION COPY (INITIAL) PINK OWNER COPY (INITIAL) GOLD