IREDELL COUNTY HEALTH DEPARTMENT

STATESVILLE 704-878-5305 MOORESVILLE 704-664-5281

IMPROVEMENT PERMIT / CERTIFICATE OF COMPLETION / OPERATION PERMIT / EXISTING SYSTEM INSPECTION

PROPERTY DESCRIPTION NO. 26157 DATE 3-10-97 TAX MAP NO. 4705558 7674 Watershed: ☐ Yes ☒ No

OWNER OR CONTRACTOR Ernest Runge PHONE: Business 872-6645 Home

ADDRESS 374 Long Island Rd Statesville NC

LOCATION 64W OTL Lippard Farm TR Happy Acres TL Trailway Dr Go 600ft lot on left

SUBDIVISION Casa Grande BLOCK / SECTION I LOT 21 LOT AREA 15,253sq Ft SITE CLASS. 0/S DESIGN FLOW 240 L.T.A.R. 0.3

Septic Tank: 1000 Gallons; STB 1012 Date 5-12-98

Pump Tank: Gallons; PT Date

Pump Make: Model Serial No.

Nitrification Field: No Fields 1 Square Feet 800 Linear Feet 266

No Lines 4 Trench Width 36in Max Trench Bottom Depth 36in Gravel Depth 12

☒ New System ☐ Repair System Type: I, II, III, IV, V, VI

System Description: Gravity Conventional

Repair System Description: Gravity Conventional

Maintenance Agreement Required: ☐ Yes ☒ No

☐ House/Mod. Home ☒ Mobile Home ☐ Business ☐ Other

No. Bedrooms 2 No. Bathrooms 2 No. Employees


Water Supply: ☐ Individual ☐ Community ☒ Public

☐ Slab ☒ Crawl Space ☐ Basement w/plumbing ☐ Basement wo/plumbing

Comments: Keep lines on contour, 9ft on center

Comments:

INITIAL SITE SKETCH

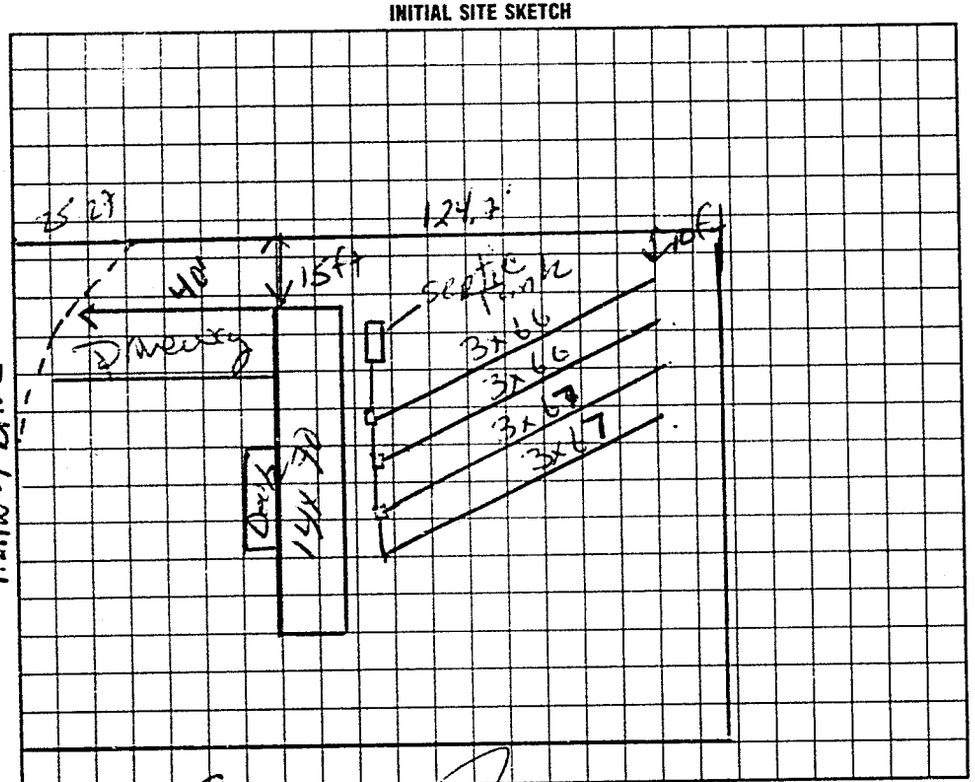

AS BUILT SKETCH

Installed as shown.

I understand that this permit can be suspended or revoked if any false information is supplied toward securing the permit/any unauthorized changes are made to the site/any unauthorized changes are made in the installation of the system. Improvement Permit is valid for 60 months from date of issuance. Authorization to const. expires 5yrs from issue date

Signed:

Installed by: A-1 Backhoe

Improvement Permit by: Mark C Outlaw RS date 3-10-97

~~Building~~ System Inspection by: Authorization to Const. Mark C Outlaw RS date 3-10-97

~~Certificate of Completion by:~~ date

Operation Permit by: Mark C Outlaw RS date 7-17-98

HEALTH DEPT. COPY: WHITE INSPECTION COPY (FINAL): GREEN OWNER COPY (FINAL): YELLOW INSPECTION COPY (INITIAL): PINK OWNER COPY (INITIAL): GOLD

1 1 6 0 0