* Repair

IREDELL COUNTY HEALTH DEPARTMENT

STATESVILLE 704-878-5305 MOORESVILLE 704-664-5281

IMPROVEMENT PERMIT / AUTHORIZATION TO CONSTRUCT / OPERATION PERMIT / EXISTING SYSTEM INSPECTION

PERMIT# Repair PIN# 4705-58-1550 DATE 9 June 09

OWNER OR APPLICANT James Dobbins PHONE: Business Home (704) 437-6778

ADDRESS 144 Trailways Dr. Statesville

LOCATION Hwy 90 W TL Upper Fancy Rd. TR Happy Acres TL Trailways - 144 on Rt.

SUBDIVISION Happy Acres BLOCK / SECTION LOT 22 LOT AREA SITE CLASS. — DESIGN FLOW 300 gpd L.T.A.R. —

Septic Tank: 1000 Gallons: STB 760 Date 1-25-09
Pump Tank: Gallons: PT Date
Pump Make: Model Serial No.
Nitrification Field: No Fields Square Feet Linear Feet
No Lines Trench Width Max Trench Bottom Depth Gravel Depth ☐ Gravity ☐ Pressure

☐ New System ☑ Repair ☐ Expansion System Type: I (II) III IV V VI
System Description:
Repair System Description: * Replace Tank
Maintenance Agreement Required: ☐ Yes ☐ No


☐ House/Mod. Home No. Bedrooms 3
☑ Mobile Home No. Persons
☐ Business No. Employees
☐ Other

Water Supply: ☐ Individual ☑ Public ☐ Community

☐ Slab ☐ Crawl Space ☐ Basement w/plumbing ☐ Basement wo/plumbing

Comments:/Conditions: Existing system not surfacing. Septic tank crushed by Time Warner truck. * Replace Septic Tank. Properly Abandon old tanks.

INITIAL SITE SKETCH

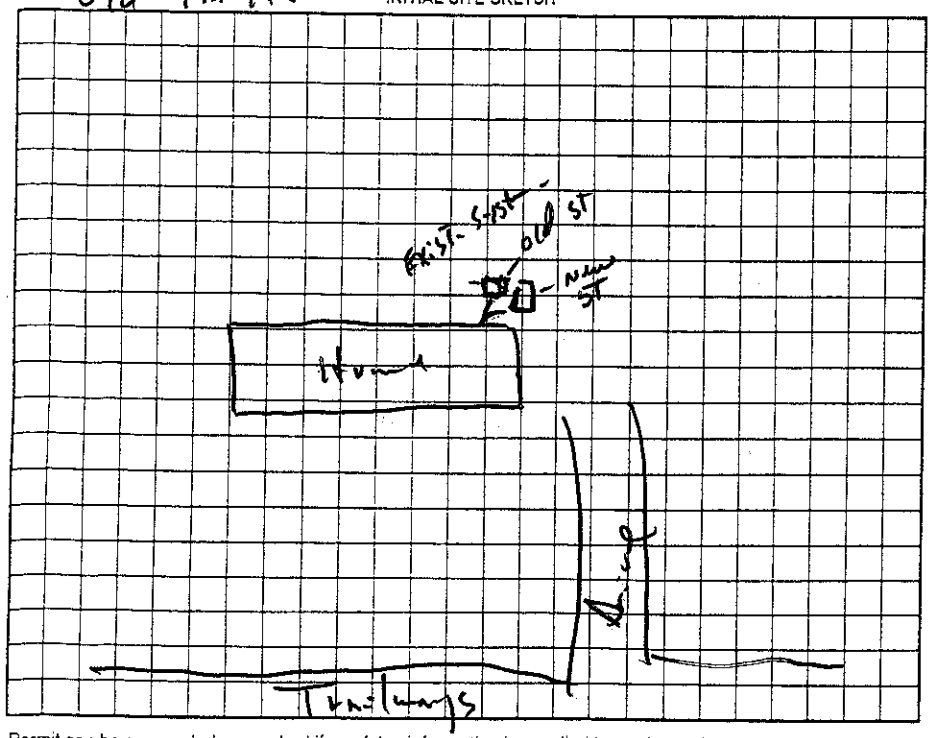

Comments:/Conditions: Red Surface Septic marker

AS-BUILT SKETCH

Permit can be suspended or revoked if any false information is supplied toward securing the permit/any unauthorized changes are made to the site/any unauthorized changes are made in the installation of the system. Improvement Permit with plat valid without expiration ☐. Improvement Permit with site plan valid for sixty months ☐ Authorization to Construct is valid for a period equal to that of Improvement Permit – not to exceed sixty months.

Signed: James Dobbins date

Improvement Permit by: date

Authorization to Construct by: date 9 June 09

Installed by: A-1 Backhoe

Operation Permit by: date 6-26-09

Existing System Inspection by: date

HEALTH DEPT. COPY: WHITE OWNER COPY (FINAL): YELLOW OWNER COPY (INITIAL): PINK