IREDELL COUNTY HEALTH DEPARTMENT

STATESVILLE 704-878-5305 &I MOORESVILLE 704-664-5281

IMPROVEMENT PERMIT / AUTHORIZATION TO CONSTRUCT / OPERATION PERMIT / EXISTING SYSTEM INSPECTION

PERMIT# 107164 PIN# 4705-58-7556 DATE 7/8/02

OWNER OR CONTRACTOR Gloria Wright PHONE: Business — Home (704) 872-3313

ADDRESS 630 St. Andrews Road Statesville, N.C 28625

LOCATION

SUBDIVISION Happy Acres BLOCK / SECTION LOT 23 LOT AREA SITE CLASS I5 DESIGN FLOW 360 L.T.A.R. .30

Septic Tank 1000 Gallons: STB — Date —
Pump Tank: Gallons: PT Date
Pump Make: Model Serial No.
Nitrification Field: No Fields 1 Square Feet Eq to P20 Linear Feet 200'
No Lines 5 Trench Width 2.5' Max Trench Bottom Depth 30" Gravel Depth SAND

[X] New System [ ] Repair System Type: I II III IV V VI
System Description: Gravity Panel
Repair System Description: Pump, Panel
Maintenance Agreement Required: [ ] Yes [X] No

[ ] House/Mod. Home No. Bedrooms 3
[X] Mobile Home No. Bathrooms 2
[ ] Business No. Employees
[ ] Other


[ ] Slab [X] Crawl Space [ ] Basement w/plumbing [ ] Basement wo/plumbing

Water Supply: [ ] Individual [X] Public [ ] Community


Comments/Conditions: ① Install 46 penetr. 4/ 33 Tons Sand ② Install on contour ③ Rake + Lime Sidewalls of trench ④ maintain proper Setbacks ⑤ call HD if helps needed prior to installation ⑥ Abandon old Septic lines ⑦ Replace Septic Tank if needed

Comments/Conditions: old S/W mH Not replaced as of 8-14-02
old ST + Tee - okay

INITIAL SITE SKETCH

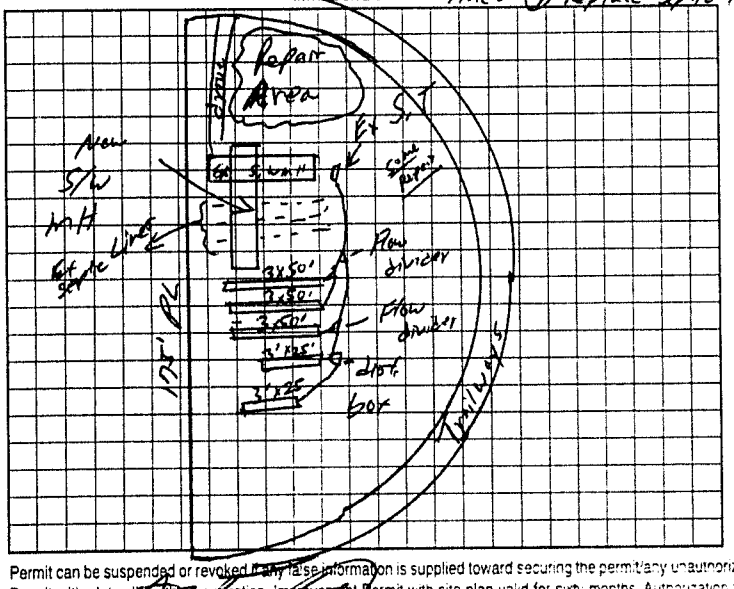

AS BUILT SKETCH

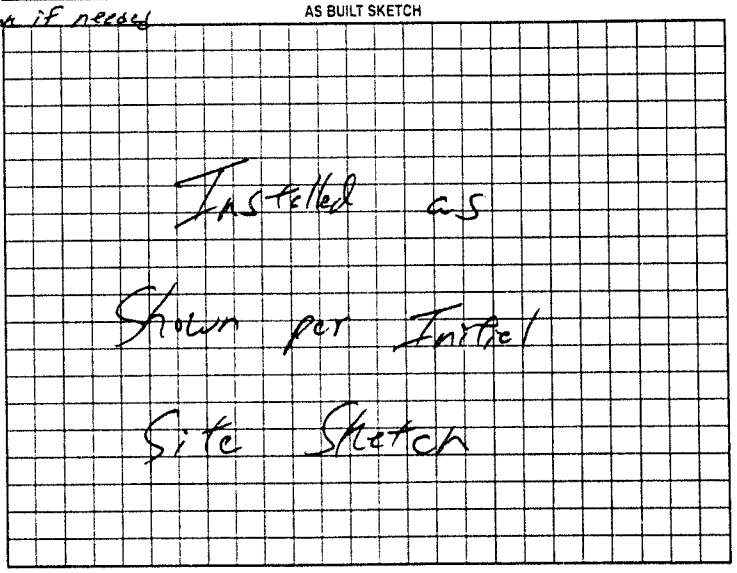

Permit can be suspended or revoked if any false information is supplied toward securing the permit; any unauthorized changes are made to the site; any unauthorized changes are made in the installation of the system. Improvement Permit with plat valid without expiration. Improvement Permit with site plan valid for sixty months. Authorization to Construct is valid for a period equal to that of Improvement Permit - not to exceed sixty months

Signed: [signature] date

Improvement Permit by: William O. Johnson date 7/8/02

Authorization to Construct by: William O. Johnson date 7/8/02

Installed by Scott Greene

Operation Permit by William O. Johnson date 8/14/02

Existing System Inspection by: date

HEALTH DEPT COPY WHITE OWNER COPY (FINAL) YELLOW OWNER COPY (INITIAL) PINK