IREDELL COUNTY HEALTH DEPARTMENT

Statesville Phone TR 3-7271 Mooresville Phone No. 664-5281

PERMIT TO INSTALL SEPTIC TANK

Permit No. _____ Permit Date 8-1 1973

Owner Shady Lane Trailer Park Address Statesville NC

Installed By Lackey Bros Address Stony Point NC


Location of Property Hwy # 90 To Don Murdocks Store, T.L. on Liddard Rd Trailer Park on R

Tank		Capacity		Length of Lines		Fixtures	
Block	( )	1000	( )	225'	( )	No. of Baths	( )
Precast	( )	1250	( )	250'	( )	Dishwasher	( )
		1500	( )	Other 300		Garbage Grdr.	( )
		Other _____				Other _____	

NOTIFY HEALTH DEPARTMENT AT LEAST EIGHT HOURS BEFORE TANK IS TO BE INSPECTED.

Final Inspection 8-1 1973 Approved (✓) Disapproved ( )

Remarks _____

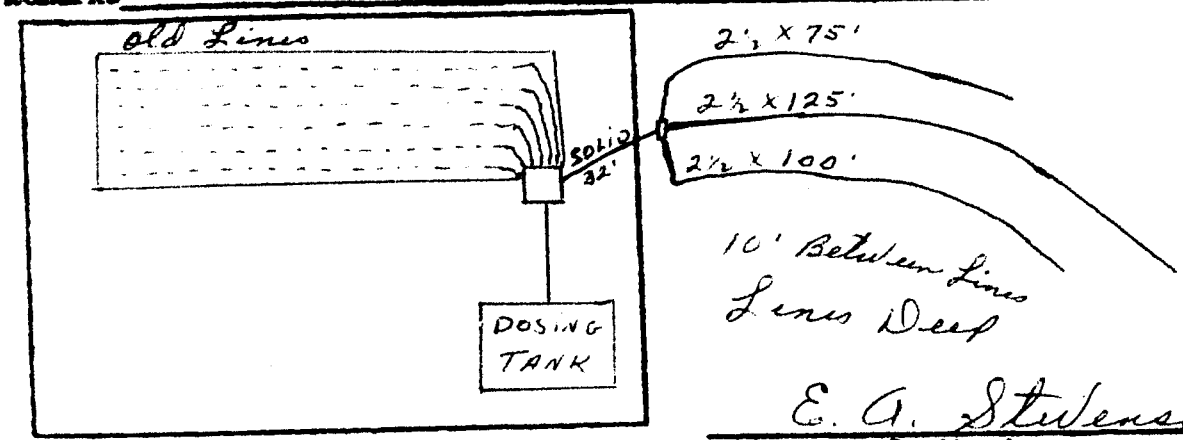

Sketch of Installation

E. A. Stevenson

Sanitarian