52926

IREDELL COUNTY HEALTH DEPARTMENT

STATESVILLE 704-878-5305 MOORESVILLE 704-664-5261

IMPROVEMENT PERMIT / CERTIFICATE OF COMPLETION / OPERATION PERMIT / EXISTING SYSTEM INSPECTION

PROPERTY DESCRIPTION NO. 16557 DATE 6-28-93 TAX MAP NO. 8T-A-48

OWNER OR CONTRACTOR Richard L. Elder PHONE: Business Home 871-3332

ADDRESS

LOCATION I40 W TR Old Mtn. Rd. TR Island Ford Rd. TL Lippard Farm Rd. Lot on R in corner of Lippard Farm Rd.

SUBDIVISION NA BLOCK / SECTION LOT 11 LOT AREA 2.4 acres SITE CLASS PS L.T.A.R. .35 gpd/ft² + Homeplace Ln.

Water Supply: ☐ Individual ☐ Community ✓ Public County water Hydromatic

Septic Tank: 1250 1000 Gallons; STB 1012 Date 5-27-95 1/2 Hp. JAT

Pump Tank: 1000 Gallons; PT 17 Date 4-10-95 SHEF, Som II

Nitrification Field: No Fields 1 Square Feet 1055 Linear Feet 345

No Lines 4 Trench Width 36" Trench Depth 36" Gravel Depth 12"

✓ New System ☐ Repair System Type: I, II, III, IV, V, VI

System Description: Pump to conventional

Repair System Description: " "

Maintenance Agreement Required: ☐ Yes ✓ No

✓ House/Mod. Home No. Bedrooms 3 Garbage Disposal: ✓ Yes ☐ No

☐ Mobile Home No. Bathrooms 2.5 Auto. Dishwasher: ✓ Yes ☐ No


☐ Business No. Employees — Auto. Washing Machine: ✓ Yes ☐ No

☐ Other Other

☐ Slab ☐ Crawl Space ✓ Basement w/plumbing ☐ Basement wo/plumbing


Comments Pump to Pressure manifold. (conventional trenches) Keep Nitrification Lines on contour. Keep system 25' from foundation of home, 10' from all property lines, and 10' from water line. Pressure manifold design attached. Pump to be sized at a date before installation. 100% Repair below system, conventional.

INITIAL SITE SKETCH

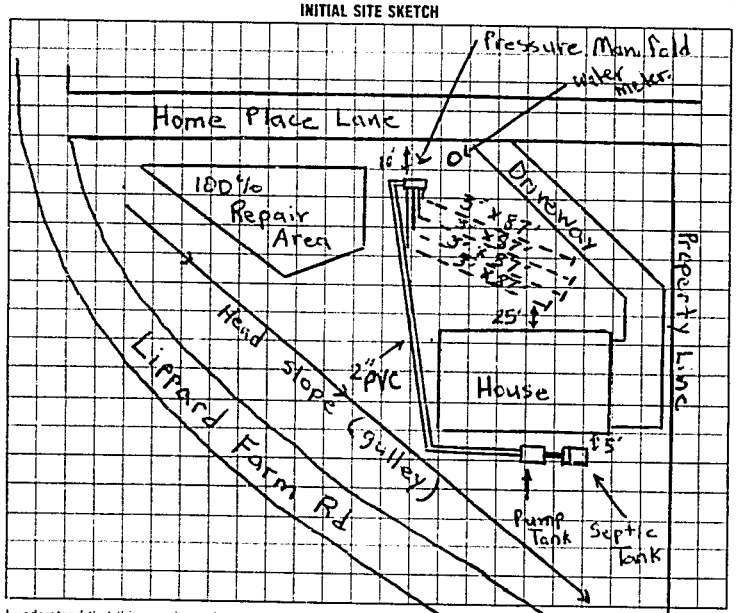

AS BUILT SKETCH

Inspected 1st and 2nd floor on 8-18-95. Also inspected Septic Tank and pump tank. Inspected last 3 lines on 8-21-95. Also inspect pump and pressure manifold on 8-21-95. Checked plants, NEMA 4X Box and water meter moved on 11-27-95. Alarm and alarm float checked on 11-29-95.

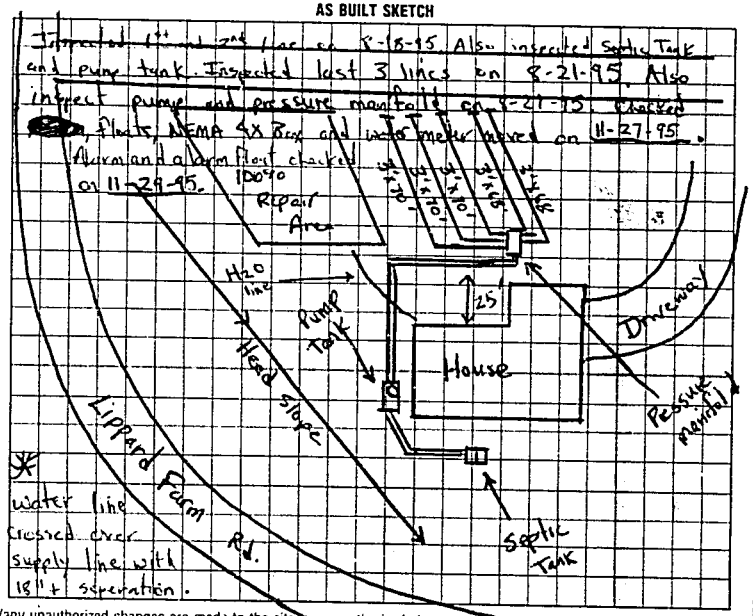

I understand that this permit can be suspended or revoked if any false information is supplied toward securing the permit/any unauthorized changes are made to the site/any unauthorized changes are made in the installation of the system. Improvement Permit is valid for 60 months from date of issuance

Signed: Richard L. Elder

Improvement Permit by: Michael J. Dennis J. L. Moore date 6-25-93

Existing System Inspection by: date

Installed by: Tommy Cothren

Certificate of Completion by: date

Operation Permit by: Michael J. Dennis date 11-29-95

HEALTH DEPT COPY WHITE INSPECTION COPY (FINAL) GREEN OWNER COPY (FINAL) YELLOW INSPECTION COPY (INITIAL) PINK OWNER COPY (INITIAL) GOLD

8 2 1 0 0 0