FIRST FLOOR PLAN
SCALE: 1/4"=1'-0"
9'-0" CEILING HEIGHT

WOOD
TILE

AREA CALCULATIONS
1852 SQ FT FIRST FLOOR HEATED 1254 SQ FT SECOND FLOOR HEATED
3106 SQ FT TOTAL HEATED 240 SQ FT PORCHES 538 SQ FT GARAGE
3884 SQ FT TOTAL

Approved as noted
Plans subject to all
Ordinances
Date 10-26-05


ALL APPLICABLE CODES SHALL BE CONSIDERED AS PART OF THE SPECIFICATIONS FOR THIS BUILDING AND SHALL TAKE PREFERENCE OVER ANYTHING SHOWN, ESCRIBED OR APPLIED. WHERE SAME ARE AT VARIANCE. DIMENSIONS SHALL BE USED IN PREFERENCE TO SCALED DIMENSIONS. CONTRACTOR SHALL VERIFY ALL DIMENSIONS AND SITE CONDITIONS BEFORE BEGINNING WORK.

REVISIONS:

CLIENT:
MR. & MRS. THOMAS

PREPARED BY:
TODD KING
2026 HWY 258 SOUTH
SNOW HILL, NC 28580
252-747-5417

DRAWING: FIRST FLOOR PLAN
SCALE: 1/4"=1'-0"
DATE=8-16-05
SHEET #3

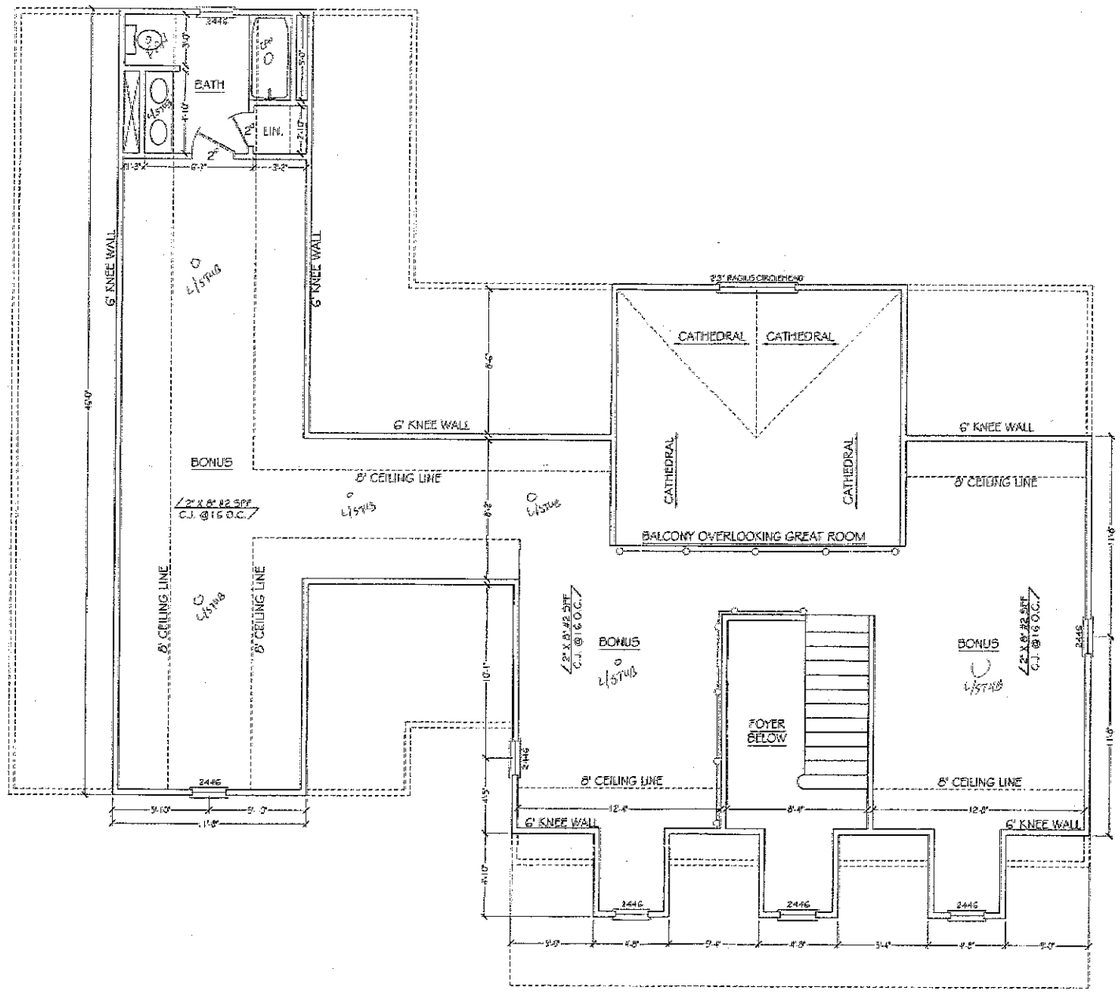

SECOND FLOOR PLAN

SCALE: 1/4"=1'-0"
8'-0" CEILING HEIGHT

ALL APPLICABLE CODES SHALL BE CONSIDERED AS PART OF THE SPECIFICATIONS FOR THIS BUILDING AND SHALL TAKE PRECEDENCE OVER ANYTHING SHOWN, DESCRIBED, OR APPLIED WHERE SAME ARE AT VARIANCE. DIMENSIONS SHALL BE USED IN PREFERENCE TO SCALED MEASUREMENTS AND CONTRACTOR SHALL VERIFY ALL DIMENSIONS AND SITE CONDITIONS BEFORE BEGINNING WORK.

REVISIONS:

CLIENT:
MR. & MRS. THOMAS

PREPARED BY:
TODD KING
2026 HWY 258 SOUTH
SNOW HILL, NC 28580
252-747-5417

DRAWING: SECOND FLOOR PLAN
SCALE: 1/4"=1'-0"
DATE=8-16-05
SHEET #4