IREDELL COUNTY HEALTH DEPARTMENT

Statesville Phone TR 3-7271 Mooresville Phone No. 664-5281

PERMIT TO INSTALL SEPTIC TANK

Permit No. 1977 Permit Date 2-22 1973

Owner Frank E. White Address Statesville N.C.

Installed By Sam Cstwalt Address Troutman N.C.


Location of Property Hwy 90 to Don Murdocks Store T.L. on Rd #1521 (Liggard Rd) Cross Creek. T.L. on Dirt Rd #1520 Last trailer on R.

Tank		Capacity		Length of Lines		Fixtures	
Block	( )	1000	(✓)	225'	(✓)	No. of Baths	(1)
Precast	(✓)	1250	( )	250'	( )	Dishwasher	( )
		1500	( )	Other		Garbage Grdr.	( )
		Other				Other	

NOTIFY HEALTH DEPARTMENT AT LEAST EIGHT HOURS BEFORE TANK IS TO BE INSPECTED.

Final Inspection 2.22 1973 Approved (✓) Disapprcved ( )

Remarks West Iredell Water Corp

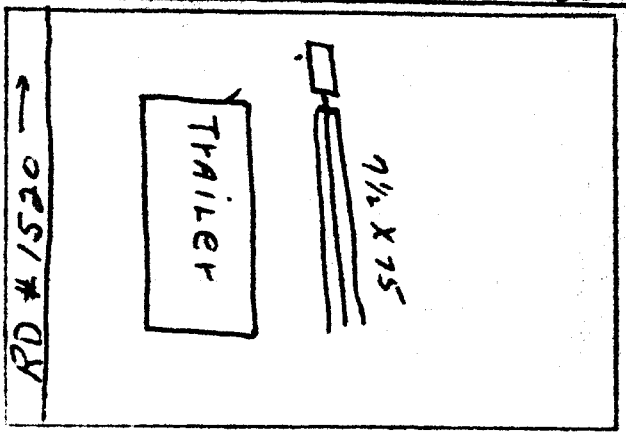

Sketch of Installation

For 1 trailer only.

E. G. Stevenson

Sanitarian