IREDELL COUNTY HEALTH DEPARTMENT

STATESVILLE 704-878-5305 (CI) 704 8626 MOORESVILLE 704-664-5281

IMPROVEMENT PERMIT / AUTHORIZATION TO CONSTRUCT / OPERATION PERMIT / EXISTING SYSTEM INSPECTION

PERMIT # 153580 PIN # 4705-66-0989 DATE 4 December 08

OWNER or APPLICANT Monroe Overcash PHONE: Business Home: 704-876-6305

OWNER or APPLICANT ADDRESS 146 Estate Dr. Statesville, N.C

LOCATION / DIRECTIONS 6006 Lippard Farm Rd. / Hwy 64 TL Lippard Farm Rd. - ON left past airport Drive

SUBDIVISION BLOCK / SECTION LOT # LOT AREA DESIGN FLOW 240 gpd L.T.A.R. 0.3 gpd/ft²/d

Septic Tank 1000 Gallons: STB 1007 Date 12-1-08	☑ New System ☐ Repair ☐ Expansion System Type I II III IV V VI	☑ Residence No. Bedrooms 2	Water Supply
Pump Tank Gallons: P T Date	System Description: 25% Reduction	☐ Business No. Persons	☐ Private
Pump Make Model Serial #	Repair System Description: 25% Reduction	☐ Other No. Employees	☑ Public
Nitrification Field No Fields 1 No Lines 2 Linear Feet 200	Maintenance Agreement Required ☐ YES ☑ NO	☐ Slab ☑ Crawl Space	☐ Community
Trench Width 3' Max. Trench Bottom Depth 36" Gravel Depth NA	☑ GRAVITY ☐ PRESSURE	☐ Basement w/plumbing ☐ Basement w/o plumbing	

Comments / Conditions

Follow contour / Honor all Setback requirements. / * Power line easement Attached.

Comments / Conditions 130WLO Filter & marker
Installer should P/L 10' + Septic Lines
USED DIST. BOX with no speed levelers. ELEVATIONS OF LINES WILL RACE UP TO D-BOX

INITIAL SITE SKETCH

Please see Attached site sketch.

AS BUILT SKETCH

SIW NOT SET UP AT TIME OF CHECK

Permit can be suspended or revoked if any false information is supplied toward securing the permit / any unauthorized changes are made to the site / any unauthorized changes are made in the installation of the system.

☐ *IMPROVEMENT PERMIT w / plat valid without expiration.* ☑ *IMPROVEMENT PERMIT w / site plan valid for 60 mos.* ☑ *AUTHORIZATION TO CONSTRUCT valid for period equal to IMPROVEMENT PERMIT-not to exceed 60 mo.*

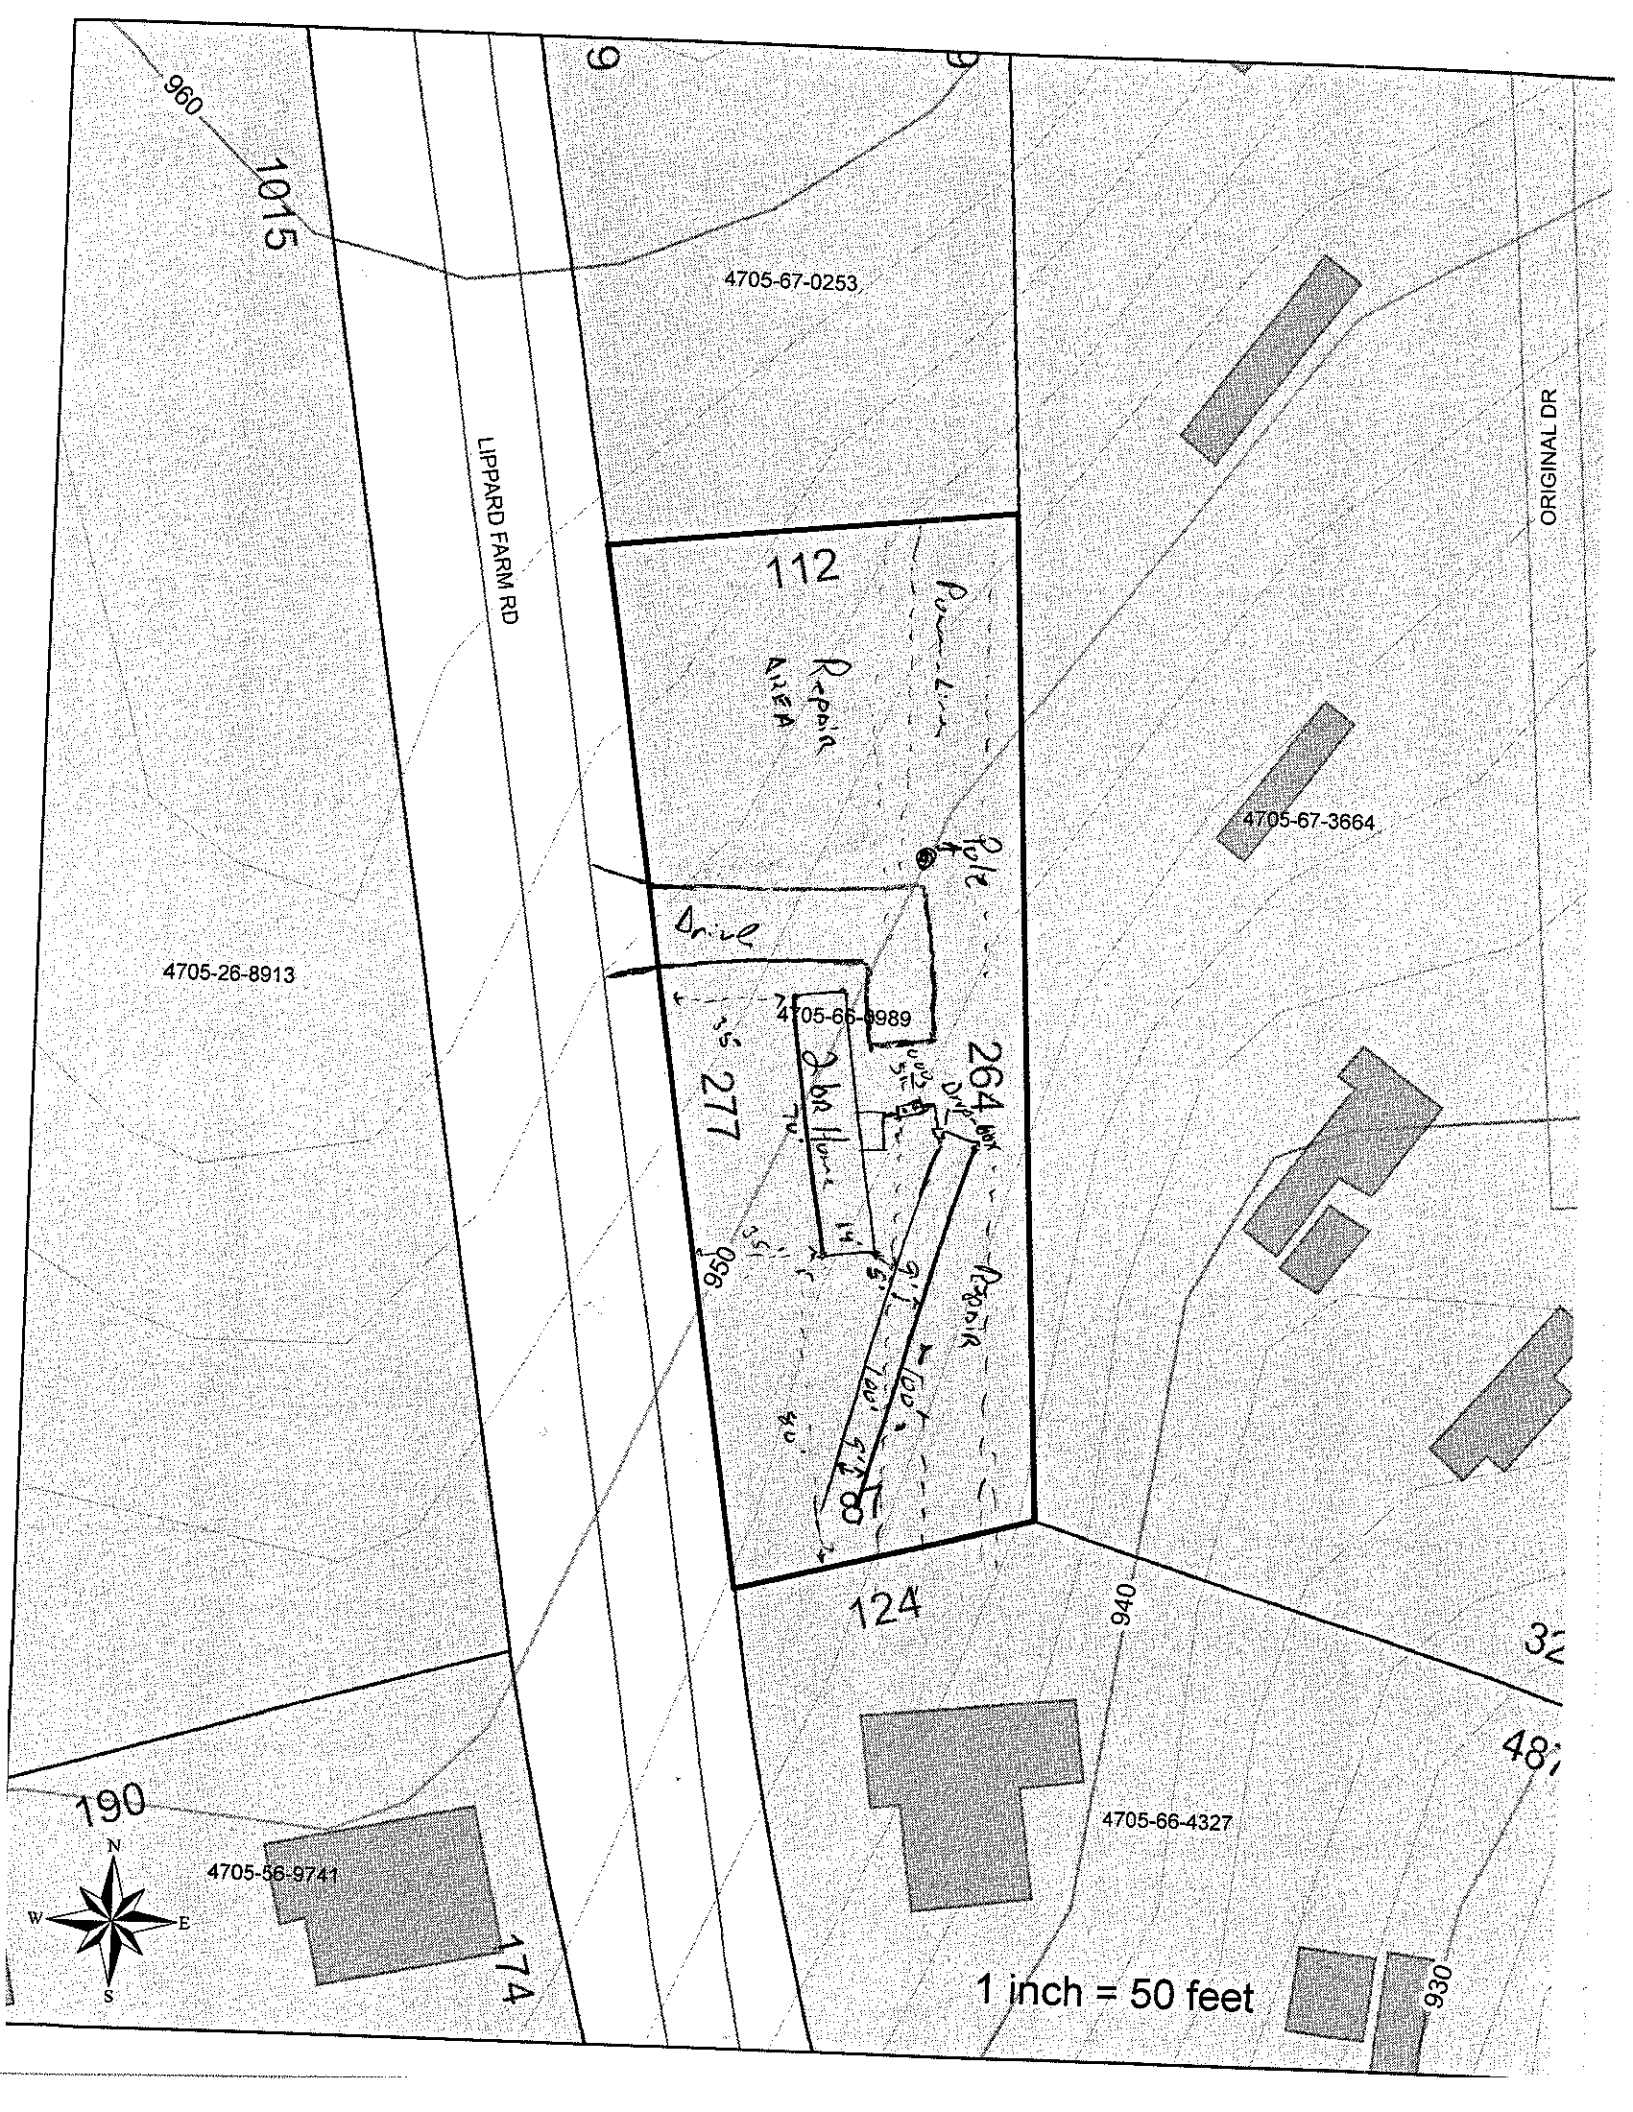
Owner / Applicant Signature: Monroe Overcash Date 12-04-08 Installed by: Bill Adams Grading

Improvement Permit by: [signature], R.S. Date 4 December 08 Operation Permit by: [signature] Date: 12-31-08

Authorization to Construct by: [signature], R.S. Date 4 December 08 Existing System Inspected by: Date:

YOU SHOULD CONTACT A LOCATOR SERVICE PRIOR TO ANY EXCAVATION.

WHITE COPY Environmental Health YELLOW COPY (Final) Owner / Applicant PINK COPY (Initial) Owner / Applicant


960
1015
4705-67-0253
LIPPARD FARM RD
ORIGINAL DR
112
Repair Area
Drive
4705-67-3664
4705-26-8913
4705-66-9989
277
264
2 br Home
950
940
124
87
190
4705-56-9741
4705-66-4327
174
930
N
W
E
S
1 inch = 50 feet