IREDELL COUNTY HEALTH DEPARTMENT

STATESVILLE 704-878-5305 MOORESVILLE 704-664-5281

IMPROVEMENT PERMIT / CERTIFICATE OF COMPLETION / OPERATION PERMIT / EXISTING SYSTEM INSPECTION

PROPERTY DESCRIPTION NO. Repair DATE 7-8-93 TAX MAP NO. Repair

OWNER OR CONTRACTOR Morris Roseman PHONE: Business Home 872-6622

ADDRESS

LOCATION I40W TR Old Mtn. Rd. TR Island Ford Rd. TL Lippard Farm Rd. TR Morris Roseman MHP

SUBDIVISION Roseman MHP BLOCK / SECTION LOT Y LOT AREA SITE CLASS. PS L.T.A.R. Repair

Water Supply: ☐ Individual ☐ Community ☑ Public county H2O

Septic Tank: — Gallons; STB — Date —

Pump Tank: — Gallons; PT — Date —

Nitrification Field: No Fields 1 Square Feet 300 Linear Feet 100

No Lines 1 Trench Width 36" Trench Depth 36" Gravel Depth 12"

☐ New System ☐ Repair System Type: I. II. III. IV. V. VI

System Description: conventional, gravity

Repair System Description:

Maintenance Agreement Required: ☐ Yes ☑ No

☐ House/Mod. Home ☑ Mobile Home ☐ Business ☐ Other

No. Bedrooms 2 No. Bathrooms 1 No. Employees

☐ Slab ☑ Crawl Space ☐ Basement w/plumbing ☐ Basement wo/plumbing

Garbage Disposal: ☐ Yes ☑ No

Auto. Dishwasher: ☐ Yes ☑ No


Auto. Washing Machine: ☑ Yes ☐ No

Other

Comments New sanitary tee installed. New d-box and 3 x 100' line installed.

INITIAL SITE SKETCH

AS BUILT SKETCH

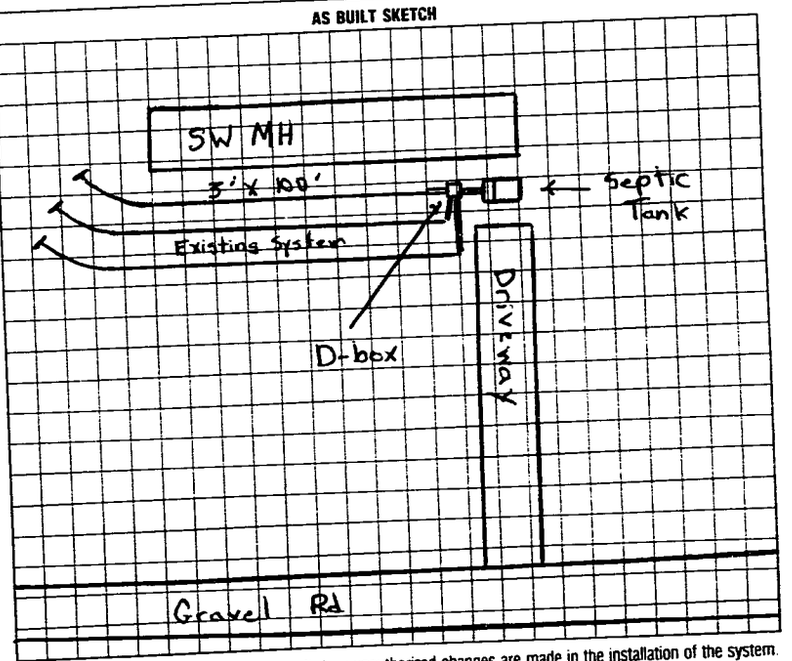

I understand that this permit can be suspended or revoked if any false information is supplied toward securing the permit/any unauthorized changes are made to the site/any unauthorized changes are made in the installation of the system. Improvement Permit is valid for 60 months from date of issuance.

Signed:

Improvement Permit by: Michael J. Dennis date 3-5-93

Existing System Inspection by: date

Installed by: James Hudler

Certificate of Completion by: Michael J. Dennis date 7-8-93

Operation Permit by: date

HEALTH DEPT. COPY: WHITE INSPECTION COPY (FINAL): GREEN OWNER COPY (FINAL): YELLOW INSPECTION COPY (INITIAL): PINK OWNER COPY (INITIAL): GOLD