# ICHD - ENVIRONMENTAL HEALTH DIVISION

States [redacted] SB 6305 Mooresville Office (704) 660-3625 PERMIT # OSWP 2023-31334

## SEPTIC: IMPROVEMENT PERMIT / AUTHORIZATION TO CONSTRUCT / OPERATION PERMIT / EXISTING SYSTEM

PIN # 4705 -67-36604

APPLICANT/OWNER: Gregory Lewis APPLICANT ADDRESS: PO Box 266 Banner Elk, NC 28604

SITE ADDRESS: 150 original Dr. Statesville 28625 PHONE: 602-582-3000 ALT. PHONE

SITE DIRECTIONS: Taylorsville Hwy - (L) Lippard Springs - (R) original Dr. SAP CONTROLLED: ☐ YES ☐ NO

SUBDIVISION: Rosemans MHP SECTION: — LOT # — LOT AREA: 13.27 DESIGN FLOW: Ex. L.T.A.R.: Ex.

| | | | | | | | | | |
|---|---|---|---|---|---|---|---|---|---|
| Septic Tank | Ex. | (gal) | STB | | Date | | | | |
| Pump Tank | | (gal) | PT | | Date | | | | |
| Pump Make | | | Model | | Serial # | | | | |
| # Nitrification Fields | Ex. | # Lines | Ex. | Linear Ft | Ex. | | | | |
| Trench Width | Ex. | Trench Bottom Depth(Low side) | Ex. | Gravel Depth | Ex. | | | | |

☐ ~~New System~~ ☐ ~~Repair~~ ☐ ~~Expansion~~ System Type: I II III IV V VI

System Description: Existing

Repair System Description: Existing

Maintenance Agreement Required: ☐ ~~YES~~ ☐ ~~NO~~

☐ ~~GRAVITY~~ ☐ ~~PRESSURE~~

☑ Residence No. Bedrooms 2

☐ Business No. Persons 4

☐ Other No. Employees

☐ Slab ☑ Crawl Space

☐ Basement w/plumbing ☐ Basement w/o plumbing

**Water Supply**


☐ Private

☐ Public

☐ Community

Comments / Conditions: System functioning properly at time of inspection.

INITIAL SITE SKETCH

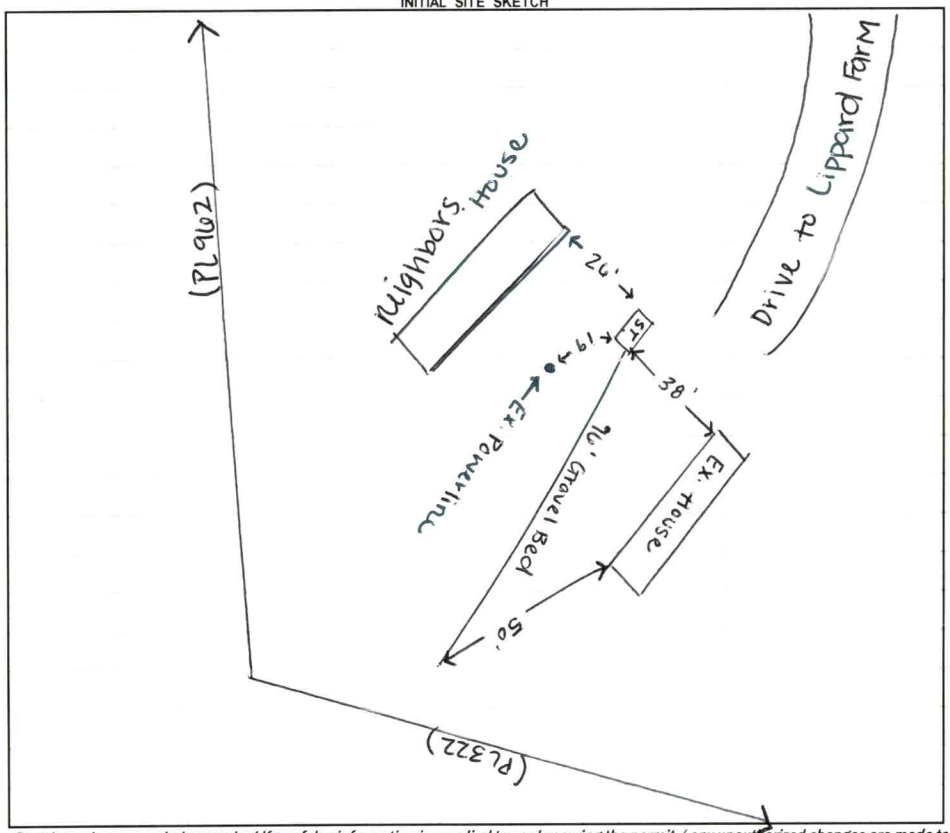


AS BUILT SKETCH

FOR SEPTIC FINAL INSPECTION CALL: 704-664-3703 between 8am-9am the day the inspection is needed. Be sure to speak with an inspector to confirm your time.

1" = 50'

*Permit can be suspended or revoked if any false information is supplied toward securing the permit / any unauthorized changes are made to the site / any unauthorized changes are made in the installation of the system.* **CONTACT A LOCATOR SERVICE PRIOR TO ANY EXCAVATION**

☐ **IMPROVEMENT PERMIT** ***with plat*** *valid without expiration.* ☑ **IMPROVEMENT PERMIT** ***with site plan*** *valid for 60 mos.* ☑ **AUTHORIZATION TO CONSTRUCT** *valid for period equal to IMPROVEMENT PERMIT--not to exceed 60 mo.*

Owner / Applicant Signature: online Date: Installed by:

IMPROVEMENT PERMIT by: Date: OPERATION PERMIT by: Date:

AUTHORIZATION TO CONSTRUCT by: Date: Existing System Inspected by: Sydney Holland Date: 8/17/23

FOR SEPTIC FINAL INSPECTION: CALL 704-664-3703 between 8am-9am the day the inspection is needed.

| Item | Date | Initials |
|---|---|---|
| Drain Lines Checked | | |
| Tanks Checked | | |
| Pressure Manifold or Valve Box Checked | | |
| Pressure Head Set | | |
| Electrical Checked | | |
| Floats Set | | |
| Alarm Checked | | |
| Maintenance Contract Needed? Y / N | | |
| Comments: | | |
| | | |
| | | |

| Repairs Only | |
|---|---|
| | State Code |
| Failing System Code | |
| Type of Distribution | G or P |
| Type of Failure/Malfunction | |
| Primary Cause of Failure/Malfunction | |
| | |
| Age of System? _____ | |
| Initial or Repair? _____ | |




**Tax Map Information**

| | |
|---|---|
| • PIN | 4705673664,000 |
| • Address | 150 ORIGINAL DR |
| • Account # | Acct 80083551 |
| • Tax Owner | LEWIS GREGORY J |
| • Mailing Address | 508 WOODTHRUSH WAY |
| • | BANNER ELK, NC 28604 |
| • GIS Owner | LEWIS GREGORY J+LINA K |
| • Deed Info | 2826 / 2011 - WD - 20210628 |
| • Tax Acres | 13.27 AC |
| • Lot # | |
| • Description | ROSEMAN SR1521 |
| • Zoning | RA |
| • Old Parcel # | 1009E00000A008A |
| • Bldg Value | $0 |
| • OBXF Value | $175,000 |
| • Land Value | $81,210 |
| • Total Value | $256,210 |
| • Defer Value | $0 |
| • Tax Districts | -ALLCNTY FIRE- - |

IREDELL COUNTY NC

MAP FOR REFERENCE ONLY
NOT A LEGAL DOCUMENT

Iredell County, North Carolina makes no claims and no warranties, expressed or implied, concerning the validity or accuracy of the GIS data presented on this map.

Geometry updated 06/05/2023
Data updated 08/03/2023

Print map scale is approximate. Critical layout or measurement activities should not be done using this resource.