IREDELL COUNTY HEALTH DEPARTMENT

STATESVILLE 704-878-5305 MOORESVILLE 704-664-5281

IMPROVEMENT PERMIT / AUTHORIZATION TO CONSTRUCT / OPERATION PERMIT / EXISTING SYSTEM INSPECTION

PERMIT# Repair PIN# DATE 4/12/01

OWNER OR CONTRACTOR Morris Roseman PHONE: Business (704) 872-6622 Home —

ADDRESS 726 Lippard Farm Road Statesville N.C. 28625

LOCATION US 64 West, (L) Lippard Farm Rd (L) Mrs. Roseman Trailer Park 2nd Trailer on left

SUBDIVISION Rosemont MHS, LLC BLOCK/SECTION Mobile Park LOT# 21 & 22 LOT AREA SITE CLASS DESIGN FLOW L.T.A.R.

Septic Tank: Existing 1,000 Gallons; STB Date

Pump Tank: Gallons; PT Date

Pump Make: Model Serial No. New

Nitrification Field: No Fields 1 Square Feet Linear Feet 290 ft

No Lines 4 Trench Width 36" Max Trench Bottom Depth 36" Gravel Depth 12"

☐ New System ☒ Repair System Type: I (II) III, IV, V, VI

System Description: Gravity, Bed

Repair System Description: Gravity Conventional

Maintenance Agreement Required: ☐ Yes ☒ No

☐ House/Mod. Home No. Bedrooms 5-6

☒ Mobile Home 5 (2) No. Bathrooms

☐ Business No. Employees

☐ Other 4 #21-22


☐ Slab ☐ Crawl Space ☐ Basement w/plumbing ☐ Basement wo/plumbing

Water Supply: ☐ Individual ☒ Public ☐ Community


Comments/Conditions: (1) Install Three (3) 90ft Lines and One(1) 50ft line to existing System (2) Add new distribution box replacing old box if needed. (3) Feed Old System First.

Comments/Conditions

INITIAL SITE SKETCH

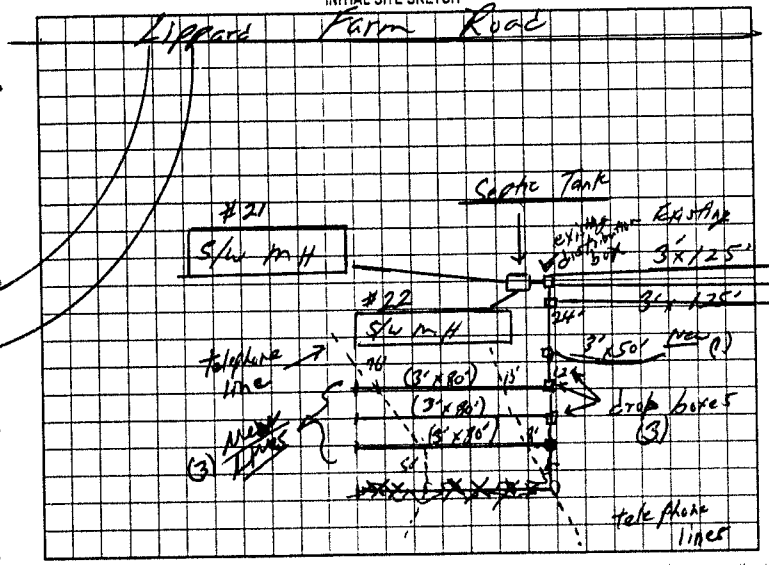

AS BUILT SKETCH

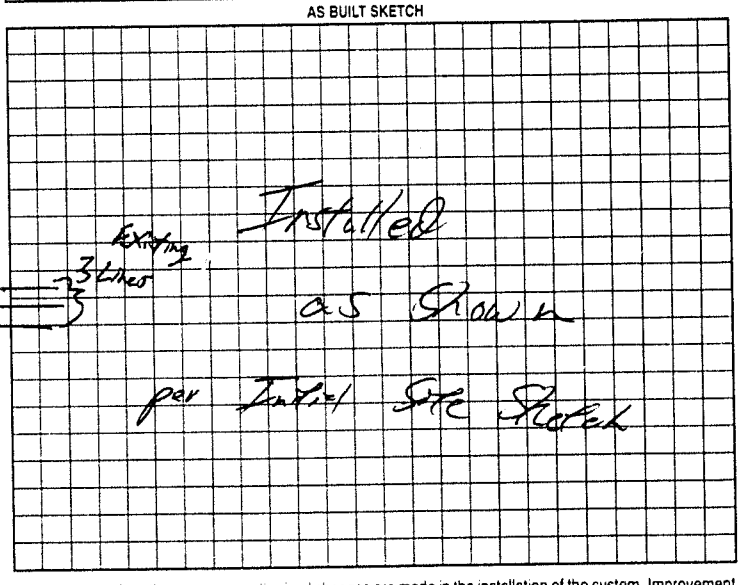

Permit can be suspended or revoked if any false information is supplied toward securing the permit/any unauthorized changes are made to the site/any unauthorized changes are made in the installation of the system. Improvement Permit with plat valid without expiration. Improvement Permit with site plan valid for sixty months. Authorization to Construct is valid for a period equal to that of Improvement Permit – not to exceed sixty months.

Signed: Morris Roseman date 4-18-01

Improvement Permit by: William Oakman RSI date 4/17/01

Authorization to Construct by: William Oakman RSI date 4/17/01

Installed by: Jody Travis / J Hyder LST

Operation Permit by: William Oakman date 5/4/01

Existing System Inspection by: date

HEALTH DEPT COPY: WHITE OWNER COPY (FINAL): YELLOW OWNER COPY (INITIAL): PINK