IREDELL COUNTY HEALTH DEPARTMENT

STATESVILLE 704-878-5305 MOORESVILLE 704-664-5281

IMPROVEMENT PERMIT / AUTHORIZATION TO CONSTRUCT / OPERATION PERMIT / EXISTING SYSTEM INSPECTION

PERMIT# 088018 PIN# 4705 68 0843 DATE 3-8-00

OWNER OR CONTRACTOR JERRY D. HAYES PHONE: Business Home 872-0442

ADDRESS 139 HAPPY ACRES DRIVE, STATESVILLE, NC 28677

LOCATION US 64 WEST, TL LIPPARD FARM RD, TR HAPPY ACRES DRIVE, 7TH LOT ON RIGHT

SUBDIVISION HAPPY ACRES BLOCK / SECTION LOT 7 & 8 LOT AREA LIMITED SITE CLASS. PS DESIGN FLOW 240 L.T.A.R. 0.30 GPD/FT2

Septic Tank: 1000 Gallons; STB 1012 Date 5/13/00
Pump Tank: Gallons; PT Date
Pump Make: Model Serial No.
Nitrification Field: No Fields 1 Square Feet 810 Linear Feet 270
No Lines FOUR Trench Width 36" Max Trench Bottom Depth 36" Gravel Depth 12"

☑ New System ☐ Repair System Type: I (II) III, IV, V, VI
System Description: CONVENTIONAL SPRAYM
Repair System Description: CONV PUMP (MAX FDS)
Maintenance Agreement Required: ☐ Yes ☑ No
☐ Slab ☑ Crawl Space ☐ Basement w/plumbing ☐ Basement wo/plumbing


☐ House/Mod. Home No. Bedrooms 2
☑ Mobile Home No. Bathrooms 1
☐ Business No. Employees
☐ Other

Water Supply: ☐ Individual ☑ Public ☐ Community

Comments:/Conditions:

Comments:/Conditions:

INITIAL SITE SKETCH

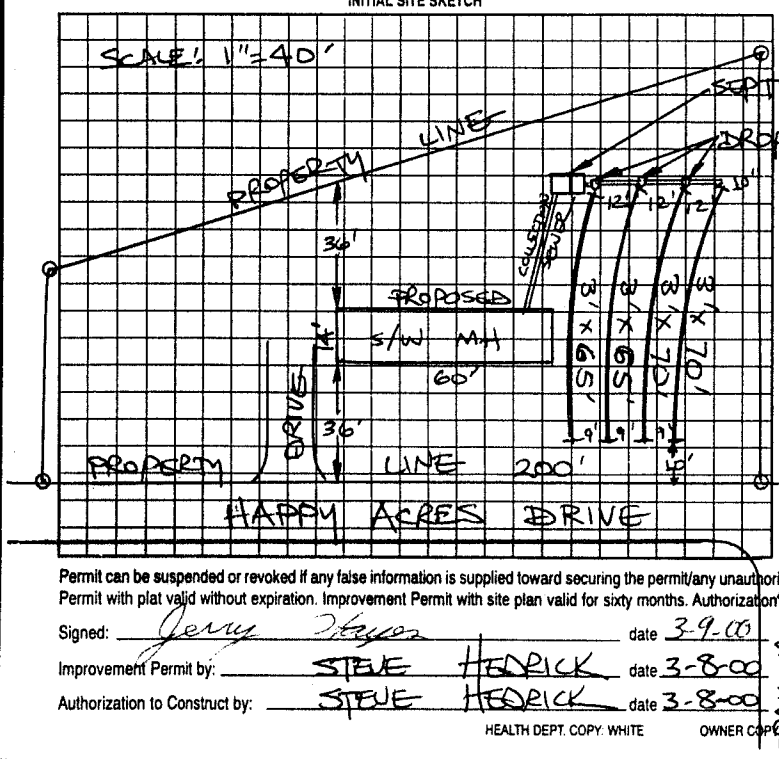

AS BUILT SKETCH

Permit can be suspended or revoked if any false information is supplied toward securing the permit/any unauthorized changes are made to the site/any unauthorized changes are made in the installation of the system. Improvement Permit with plat valid without expiration. Improvement Permit with site plan valid for sixty months. Authorization to Construct is valid for a period equal to that of Improvement Permit – not to exceed sixty months.

Signed: Jerry Hayes date 3-9-00 Installed by: A-1 Backhoe

Improvement Permit by: STEVE HEDRICK date 3-8-00 Operation Permit by: [signature] LSI date 8/3/00

Authorization to Construct by: STEVE HEDRICK date 3-8-00 Existing System Inspection by: date

HEALTH DEPT. COPY: WHITE OWNER COPY (FINAL): YELLOW OWNER COPY (INITIAL): PINK