ICHD - ENVIRONMENTAL HEALTH DIVISION

Statesville Office (704) 878-5305 Mooresville Office (704) 660-3625 PERMIT # OSWP-2023-33419

SEPTIC: IMPROVEMENT PERMIT / AUTHORIZATION TO CONSTRUCT / OPERATION PERMIT / EXISTING SYSTEM / Repair PIN # 4705 -- 68 -- 1695


APPLICANT/OWNER: DONALD MCLAIN
APPLICANT ADDRESS: 630 SAINT ANDREWS ROAD, STATESVILLE, N.C. 28625
SITE ADDRESS: 120 HAPPY ACRES DRIVE, STATESVILLE, N.C. 28677
PHONE: 704-619-3932
ALT. PHONE —
SITE DIRECTIONS: (W) ON 64, (L) ON LIPPARD FARM, (R) ON HAPPY ACRES, LOT ON (R)
SAP CONTROLLED: ☐ YES ☐ NO EXT
SUBDIVISION: CLARENCE N. LITLE HAPPY ACRES
SECTION: — LOT # 5 LOT AREA: 0.39AC
DESIGN FLOW: EXT L.T.A.R.: EXT

Septic Tank	1000	(gal)	STB 1012	Date	9/9/2023	☐ New System	☑ Repair	☐ Expansion	System Type: I (II) III IV V VI
Pump Tank	—	(gal)	PT —	Date	—	System Description:	EXISTING - CONVENTIONAL		
Pump Make	—	Model	—	Serial #	—	Repair System Description:	TANK REPLACEMENT		
# Nitrification Fields	EXT	# Lines	EXT	Linear Ft	EXT	Maintenance Agreement Required:	☐ YES	☑ NO	
Trench Width	EXT	Trench Bottom Depth(Low side)	EXT	Gravel Depth	EXT		☑ GRAVITY	☐ PRESSURE	

				Water Supply
☑ Residence	No. Bedrooms	EXT		☐ Private
☐ Business	No. Persons	EXT		☑ Public
☐ Other	No. Employees	—		☐ Community
☐ Slab	☑ Crawl Space			
☐ Basement w/plumbing	☐ Basement w/o plumbing			

Comments / Conditions: PUMP, CRUSH, AND FILL EXISTING SEPTIC TANKS, INSPECT AND REPLACE DISTRIBUTION AS NEED, DRAIN LINES APPEARED TO BE FUNCTIONING AT TIME OF INSPECTION

INITIAL SITE SKETCH

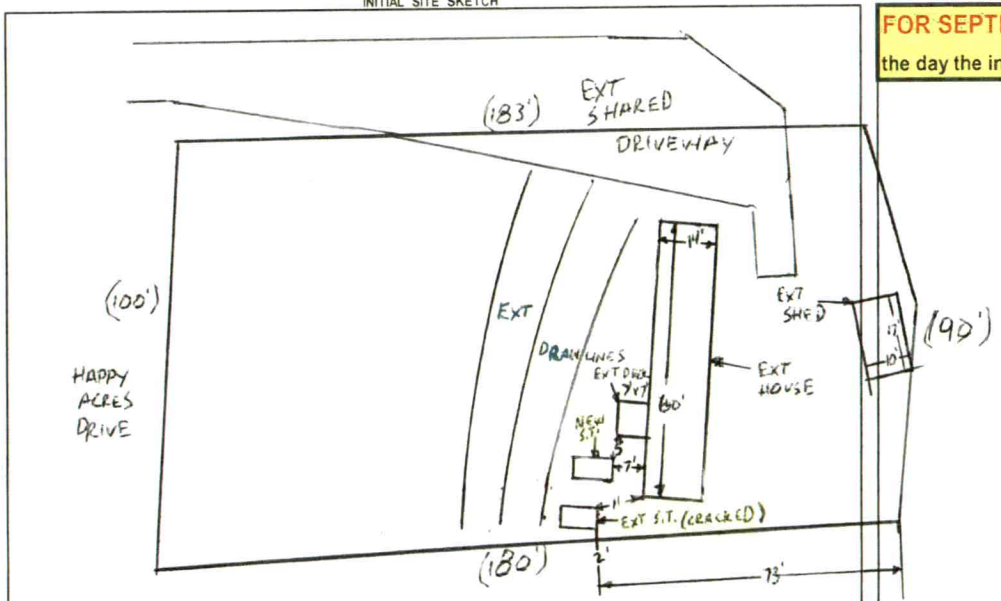

AS BUILT SKETCH

FOR SEPTIC FINAL INSPECTION CALL: 704-664-3703 between 8am-9am the day the inspection is needed. Be sure to speak with an inspector to confirm your time.

Installed as drawn.

1 IN = 40 FT
S.T. = SEPTIC TANK
EXT = EXISTING

Permit can be suspended or revoked if any false information is supplied toward securing the permit / any unauthorized changes are made to the site / any unauthorized changes are made in the installation of the system. **CONTACT A LOCATOR SERVICE PRIOR TO ANY EXCAVATION**

☐ **IMPROVEMENT PERMIT** *with plat valid without expiration.* ☑ **IMPROVEMENT PERMIT** *with site plan valid for 60 mos.* ☑ **AUTHORIZATION TO CONSTRUCT** *valid for period equal to IMPROVEMENT PERMIT--not to exceed 60 mo.*

Owner / Applicant Signature: ONLINE SIGNATURE Date: — Installed by: Kevin Powell

IMPROVEMENT PERMIT by: Benjamin C. White Date: 10-18-2023 OPERATION PERMIT by: Sarah Williams Date: 10/01/2023

AUTHORIZATION TO CONSTRUCT by: Benjamin C. White Date: 10-18-2023 Existing System Inspected by: Date:

FOR SEPTIC FINAL INSPECTION: CALL 704-664-3703 between 8am-9am the day the inspection is needed.

Item	Date	Initials
Drain Lines Checked		
Tanks Checked		
Pressure Manifold or Valve Box Checked		
Pressure Head Set		
Electrical Checked		
Floats Set		
Alarm Checked		
Maintenance Contract Needed? Y / N		
Comments:		

Repairs Only	
	State Code
Failing System Code	
Type of Distribution	G or P
Type of Failure/Malfunction	
Primary Cause of Failure/Malfunction	
Age of System? _____	
Initial or Repair? _____	