IREDELL COUNTY HEALTH DEPARTMENT - *ENVIRONMENTAL HEALTH* ☒ STATESVILLE OFFICE 704-878-5305 ☐ MOORESVILLE OFFICE 704-664-5281

IMPROVEMENT PERMIT / AUTHORIZATION TO CONSTRUCT / OPERATION PERMIT / EXISTING SYSTEM INSPECTION

PERMIT # 16895 | PIN # 4705 68 1722 | DATE March 2, 2012

OWNER Gloria Wright | APPLICANT: | PHONE: Home/Cell # 704 872 3313 | Business #

SITE ADDRESS 126 Happy Acres Drive, Statesville | OWNER / APPLICANT ADDRESS 630 St. Andrews Rd Statesville NC 28625

SITE DIRECTIONS I40 W Exit on Hwy 64/90 WEST Bear Left on Hwy 64 TL Lippard Farm Rd TR Happy Acres Dr. on Right #126

SUBDIVISION Happy Acres | BLOCK / SECTION | LOT # 6 | LOT AREA Existing | DESIGN FLOW | L.T.A.R.

Septic Tank Ex 1000 Gallons: STB Date

Pump Tank Gallons: P T Date

Pump Make Model Serial #

No. Nitrification Fields: 1 No. Lines Linear Feet Ex 240

Trench Width Ex Max. Trench Bottom Depth Ex Gravel Depth Ex

☐ New System ☐ Repair ☐ Expansion System Type I (II) III IV V VI

System Description: gravity conventional

Repair System Description:

Maintenance Agreement Required ☐ YES ☒ NO

☒ GRAVITY ☐ PRESSURE

☒ Residence No. Bedrooms 2

☐ Business No. Persons

☐ Other No. Employees

☐ Slab ☒ Crawl Space

☐ Basement w/plumbing ☐ Basement w/o plumbing

Water Supply


☐ Private

☒ Public

☐ Community

Comments / Conditions: Variance granted on rear zoning setback. Existing septic system OK at time of inspection. Septic system originally sized for 3 bedrooms, last replacing with a 2 bedroom Mobile Home.

INITIAL SITE SKETCH

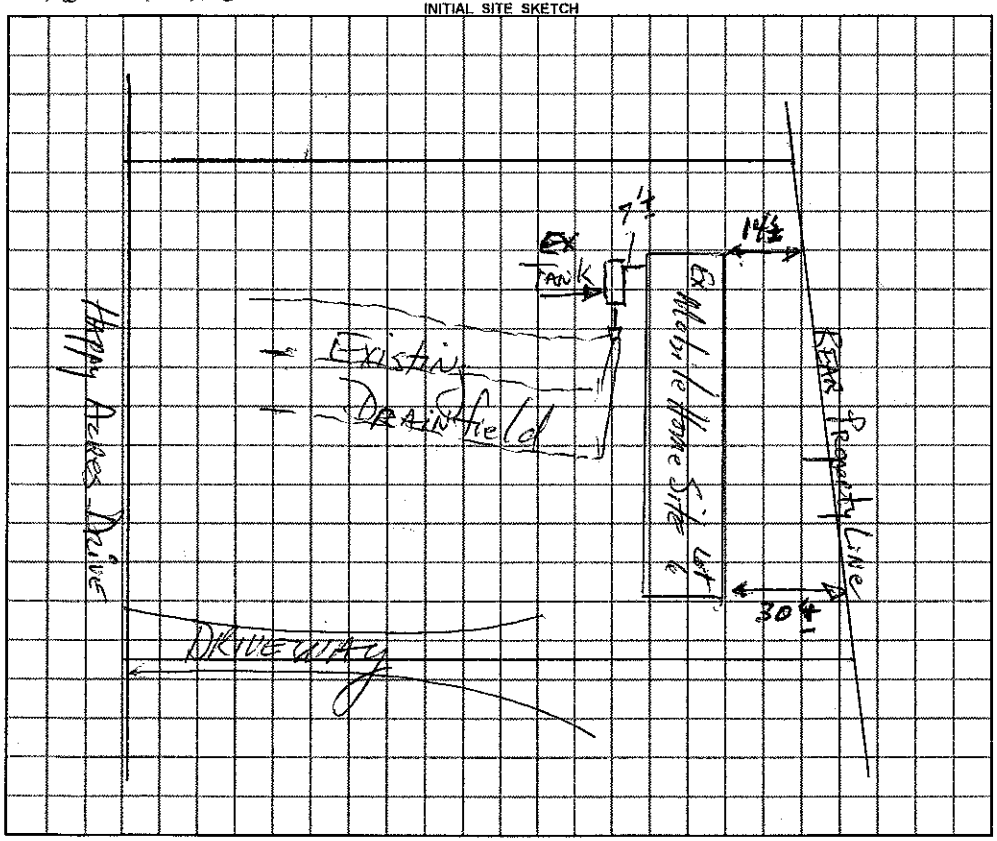

AS BUILT SKETCH

Permit can be suspended or revoked if any false information is supplied toward securing the permit / any unauthorized changes are made to the site / any unauthorized changes are made in the installation of the system.

☐ ***IMPROVEMENT PERMIT*** with plat valid without expiration. ☐ ***IMPROVEMENT PERMIT*** with plat valid without expiration. site plan valid 60 mo. ☐ ***AUTHORIZATION TO CONSTRUCT*** valid for period equal to IMPROVEMENT PERMIT--not to exceed 60 mo.

Owner / Applicant Signature: Gloria L Wright Date 3-2-12 Installed by:

IMPROVEMENT PERMIT by: REHS Date | OPERATION PERMIT by: REHS Date

AUTHORIZATION TO CONSTRUCT by: REHS Date | Existing System Inspected by: REHS Date March 2, 2012

YOU SHOULD CONTACT A LOCATOR SERVICE PRIOR TO ANY EXCAVATION

White Copy – Environmental Health YELLOW COPY (Final) Owner / Applicant PINK COPY (Initial) Owner / Applicant