IREDELL COUNTY HEALTH DEPARTMENT

Statesville Office (704) 878-5305 Mooresville Office (704) 660-3625 PERMIT # 207636

IMPROVEMENT PERMIT / AUTHORIZATION TO CONSTRUCT / OPERATION PERMIT / EXISTING SYSTEM

PIN # 4705685969

APPLICANT: Ernest Runge APPLICANT ADDRESS: 374 Lake Island Rd Statesville NC

SITE ADDRESS: 105 Proust Rd Statesville NC PHONE: 704-872-9502 ALT. PHONE: N/A

SITE DIRECTIONS: Corner of Proust Rd + Lippard Farm Rd off Hwy 64/90


SUBDIVISION: N/A SECTION: N/A LOT # N/A LOT AREA: 3.26 ac DESIGN FLOW: Ex L.T.A.R.: Ex

Septic Tank	1000 (gal)	STB	760	Date	8-23-15	☐ New System	☒ Repair	☐ Expansion	System Type: I	☒ II	III IV V VI
Pump Tank	N/A (gal)	PT	N/A	Date	N/A	System Description:	Tank				
Pump Make	N/A	Model	Polylok	Serial #	PL-68	Repair System Description:					
# Nitrification Fields	Ex	# Lines	Ex	Linear Ft:	Ex	Maintenance Agreement Required:	☐ YES	☒ NO			
Trench Width	Ex	Max. Trench Bottom Depth	Ex	Gravel Depth	Ex	☒ GRAVITY	☐ PRESSURE				

☒ Residence	No. Bedrooms	Ex	Water Supply		
☐ Business	No. Persons	Ex	☐ Private		
☐ Other	No. Employees		☐ Public		
☐ Slab	☒ Crawl Space		☒ Community		
☐ Basement w/plumbing	☐ Basement w/o plumbing				

Comments / Conditions: Pump crush & fill existing tank maintain 5' set back from any building foundation.

INITIAL SITE SKETCH

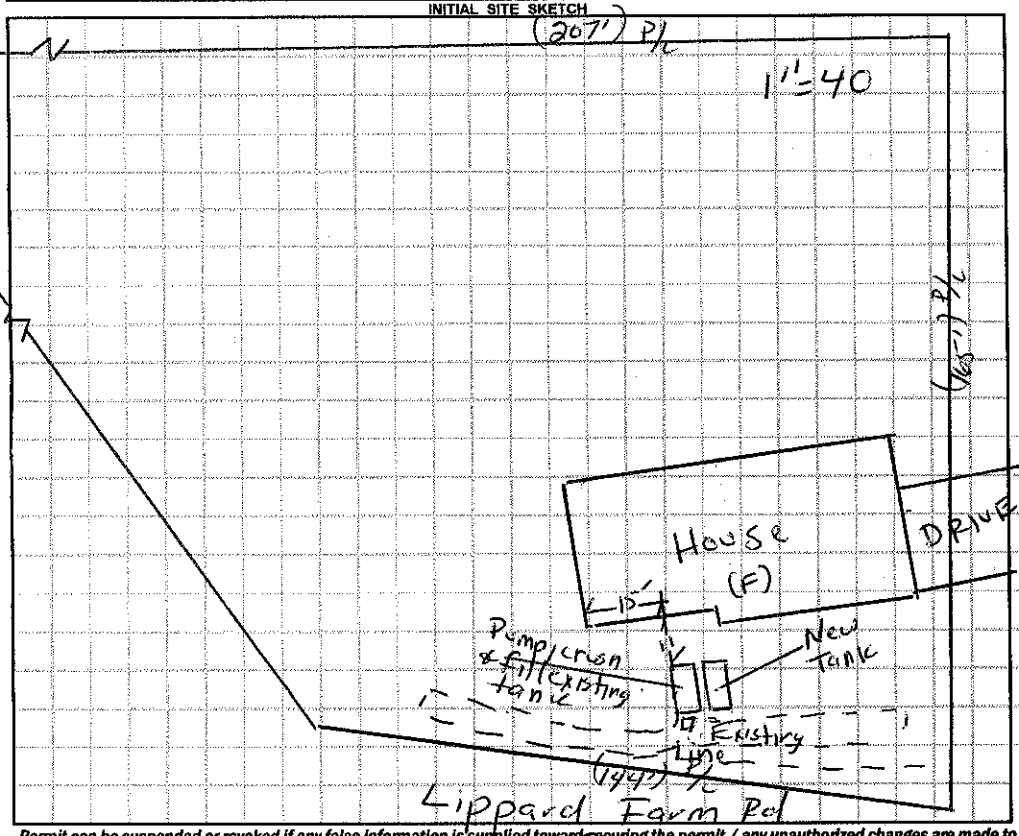

AS BUILT SKETCH

Installed as drawn

Permit can be suspended or revoked if any false information is supplied toward securing the permit / any unauthorized changes are made to the site / any unauthorized changes are made in the installation of the system. **CONTACT A LOCATOR SERVICE PRIOR TO ANY EXCAVATION**

☐ **IMPROVEMENT PERMIT** *with plat valid without expiration.* ☒ **IMPROVEMENT PERMIT** *with site plan valid for 60 mos.* ☒ **AUTHORIZATION TO CONSTRUCT** *valid for period equal to IMPROVEMENT PERMIT--not to exceed 60 mo.*

Owner / Applicant Signature: Ernest Runge Date: 12/31/14 Installed by: Lentz Septic

IMPROVEMENT PERMIT by: David Hunt Date: 12/31/14 OPERATION PERMIT by: David Hunt Date: 01/21/15

AUTHORIZATION TO CONSTRUCT by: David Hunt Date: 12/31/14 Existing System Inspected by: Date:

Health Dept. Copy - WHITE Applicant (Final Approval) - YELLOW Applicant (Conditional Approval) - PINK