IREDELL COUNTY HEALTH DEPARTMENT

STATESVILLE 704-878-5305 MOORESVILLE 704-664-5281

IMPROVEMENT PERMIT / AUTHORIZATION TO CONSTRUCT / OPERATION PERMIT / EXISTING SYSTEM INSPECTION

PERMIT# 77417 PIN# 4705 67 2681

OWNER OR CONTRACTOR Morris Roseman PHONE: Business 872 6622 Home DATE 12-2-98

ADDRESS 726 Lippard Fm Rd Statesville, N.C.

LOCATION Hwy 64 Tb Lippard Fm Tb original Tb Babson at end

SUBDIVISION Roseman BLOCK / SECTION LOT 141 Babson Dr. LOT AREA acreage SITE CLASS PS DESIGN FLOW 360 L.T.A.R. 1 3gal/sf Hay

Septic Tank: 1000 Gallons; STB 1794 Date 10-23-98

Pump Tank: Gallons; PT Date

Pump Make: Model Serial No.

Nitrification Field: No Fields 1 Square Feet 1200 Linear Feet 400

No Lines 4 Trench Width 36" Max Trench Bottom Depth 36" Gravel Depth 12"

☐ New System ☐ Repair System Type: I, II, III, IV, V, VI

System Description: conv. Gravity

Repair System Description:

Maintenance Agreement Required: ☐ Yes ☐ No

☐ House/Mod. Home ☑ Mobile Home ☐ Business ☐ Other

No. Bedrooms 3 No. Bathrooms 2 No. Employees


☐ Slab ☑ Crawl Space ☐ Basement w/plumbing ☐ Basement wo/plumbing

Water Supply: ☐ Individual ☐ Public ☐ Community

Comments/Conditions:

Comments:/Conditions:

INITIAL SITE SKETCH

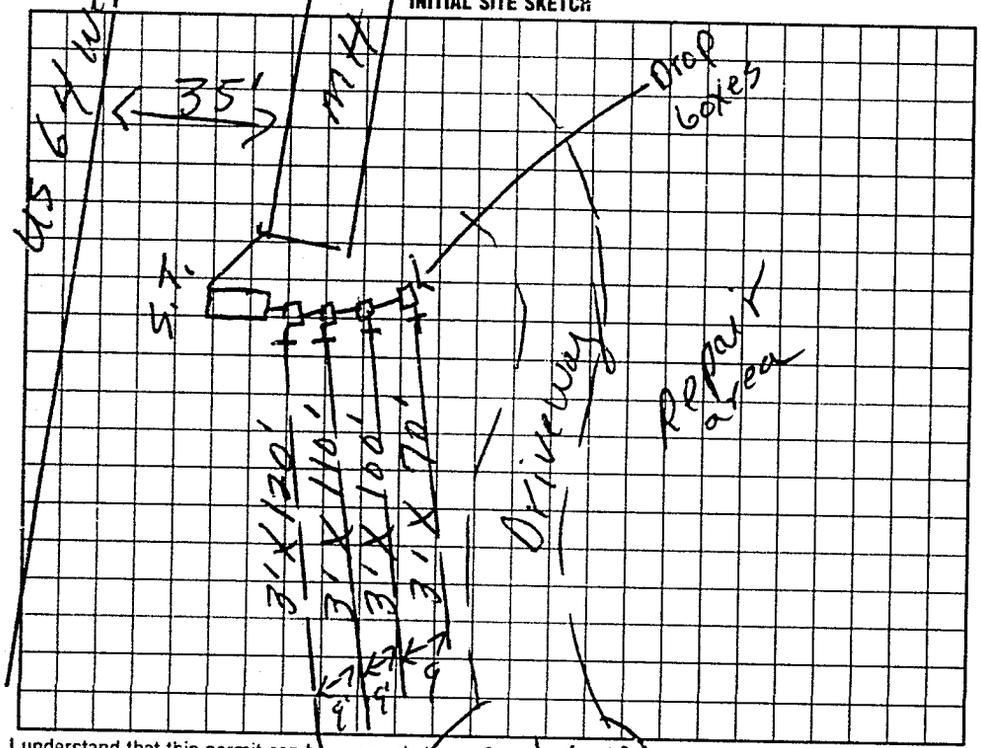

AS BUILT SKETCH

Same as initial sketch

I understand that this permit can be suspended or revoked if any false information is supplied toward securing the permit/any unauthorized changes are made to the site/any unauthorized changes are made in the installation of the system. Improvement Permit with plat valid without expiration. Improvement Permit with site plan valid for sixty months. Authorization to Construct is valid for a period equal to that of Improvement Permit – not to exceed sixty months.

Signed: X Morris Roseman date

Improvement Permit by: B. C. Moore date 12-2-98

Authorization to Construct by: B. C. Moore date 12-2-98

Installed by: James Hutler

Operation Permit by: B. C. Moore date 12-17-98

Existing System Inspection by: date

HEALTH DEPT COPY: WHITE INSPECTION COPY (FINAL): GREEN OWNER COPY (FINAL): YELLOW INSPECTION COPY (INITIAL): PINK OWNER COPY (INITIAL): GOLD