IREDELL COUNTY HEALTH DEPARTMENT

STATESVILLE 704-878-5305 MOORESVILLE 704-664-5281

IMPROVEMENT PERMIT / AUTHORIZATION TO CONSTRUCT / OPERATION PERMIT / EXISTING SYSTEM INSPECTION

PERMIT# Repair PIN# DATE 3-6-98

OWNER OR CONTRACTOR Gary Testerman PHONE: Business Home 871-2462

ADDRESS 117 Proust Rd Statesville

LOCATION 64W TR Lippard TL Proust 2st house on (L)

SUBDIVISION BLOCK / SECTION LOT LOT AREA SITE CLASS PS DESIGN FLOW 360 L.T.A.R.

Septic Tank: 1000 Gallons; STB 1007 Date 2-18-97

Pump Tank: Gallons; PT Date

Pump Make: Model Serial No.

Nitrification Field: No Fields 1 Square Feet Linear Feet 290

No Lines 4 Trench Width 36 Max Trench Bottom Depth 36 Gravel Depth 12 in

[ ] New System [X] Repair System Type: I (II) III, IV, V, VI

System Description:

Repair System Description: Gravity Convention

Maintenance Agreement Required: [ ] Yes [ ] No

[X] House/Mod. Home No. Bedrooms 3

[ ] Mobile Home No. Bathrooms 2

[ ] Business No. Employees

[ ] Other


[ ] Slab [ ] Crawl Space [ ] Basement w/plumbing [ ] Basement wo/plumbing

Water Supply: [ ] Individual [X] Public [ ] Community


Comments:/Conditions: Keep lines on contour ~ 8½-9ft on contour. Set Dist Boxes if old line clogged w/roots Don't use Check Tank & sanitary T' replace if needed. Pump Tank

Comments:/Conditions: Replaced Tank

INITIAL SITE SKETCH

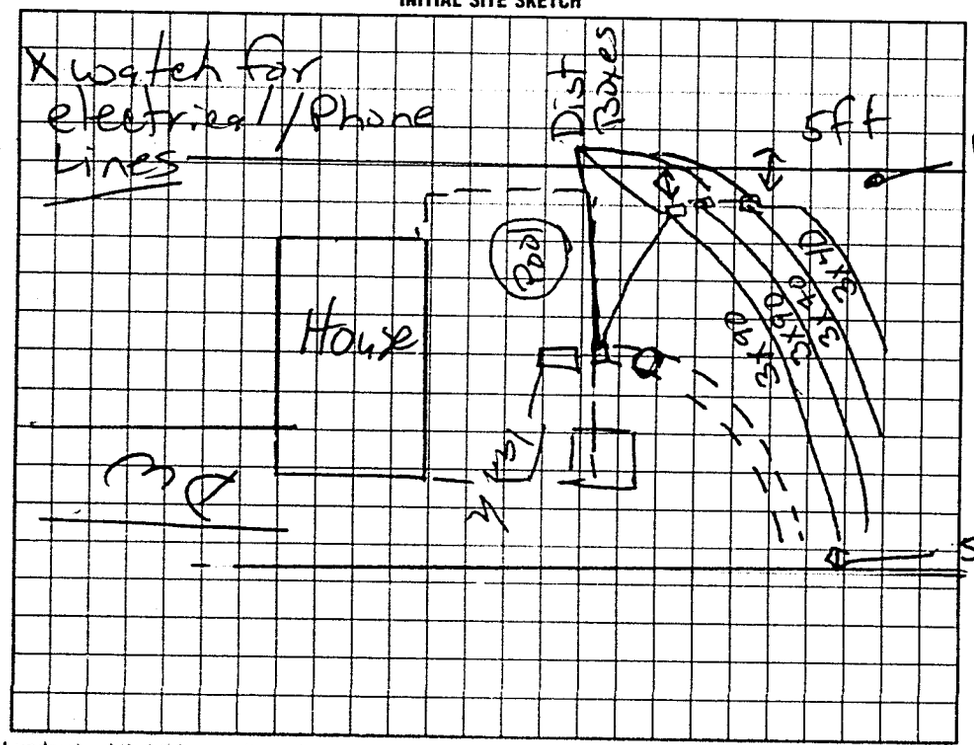

AS BUILT SKETCH

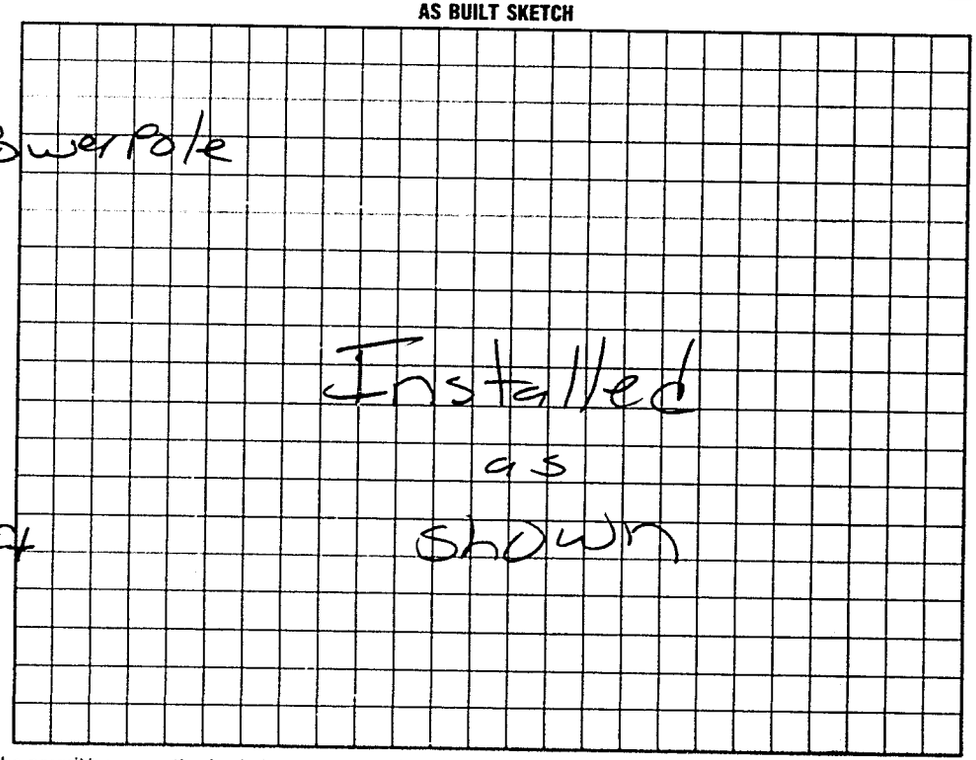

I understand that this permit can be suspended or revoked if any false information is supplied toward securing the permit/any unauthorized changes are made to the site/any unauthorized changes are made in the installation of the system. Improvement Permit with plat valid without expiration. Improvement Permit with site plan valid for sixty months. Authorization to Construct is valid for a period equal to that of Improvement Permit – not to exceed sixty months.

Signed: Donna S. Testerman date

Improvement Permit by: Mark Cox RS date 3-6-98

Authorization to Construct by: Mark Cox RS date 3-6-98

Installed by: James Huddler

Operation Permit by: Mark Cox RS date 3-23-98

Existing System Inspection by: date

HEALTH DEPT COPY: WHITE INSPECTION COPY (FINAL): GREEN OWNER COPY (FINAL): YELLOW INSPECTION COPY (INITIAL): PINK OWNER COPY (INITIAL): GOLD